


27

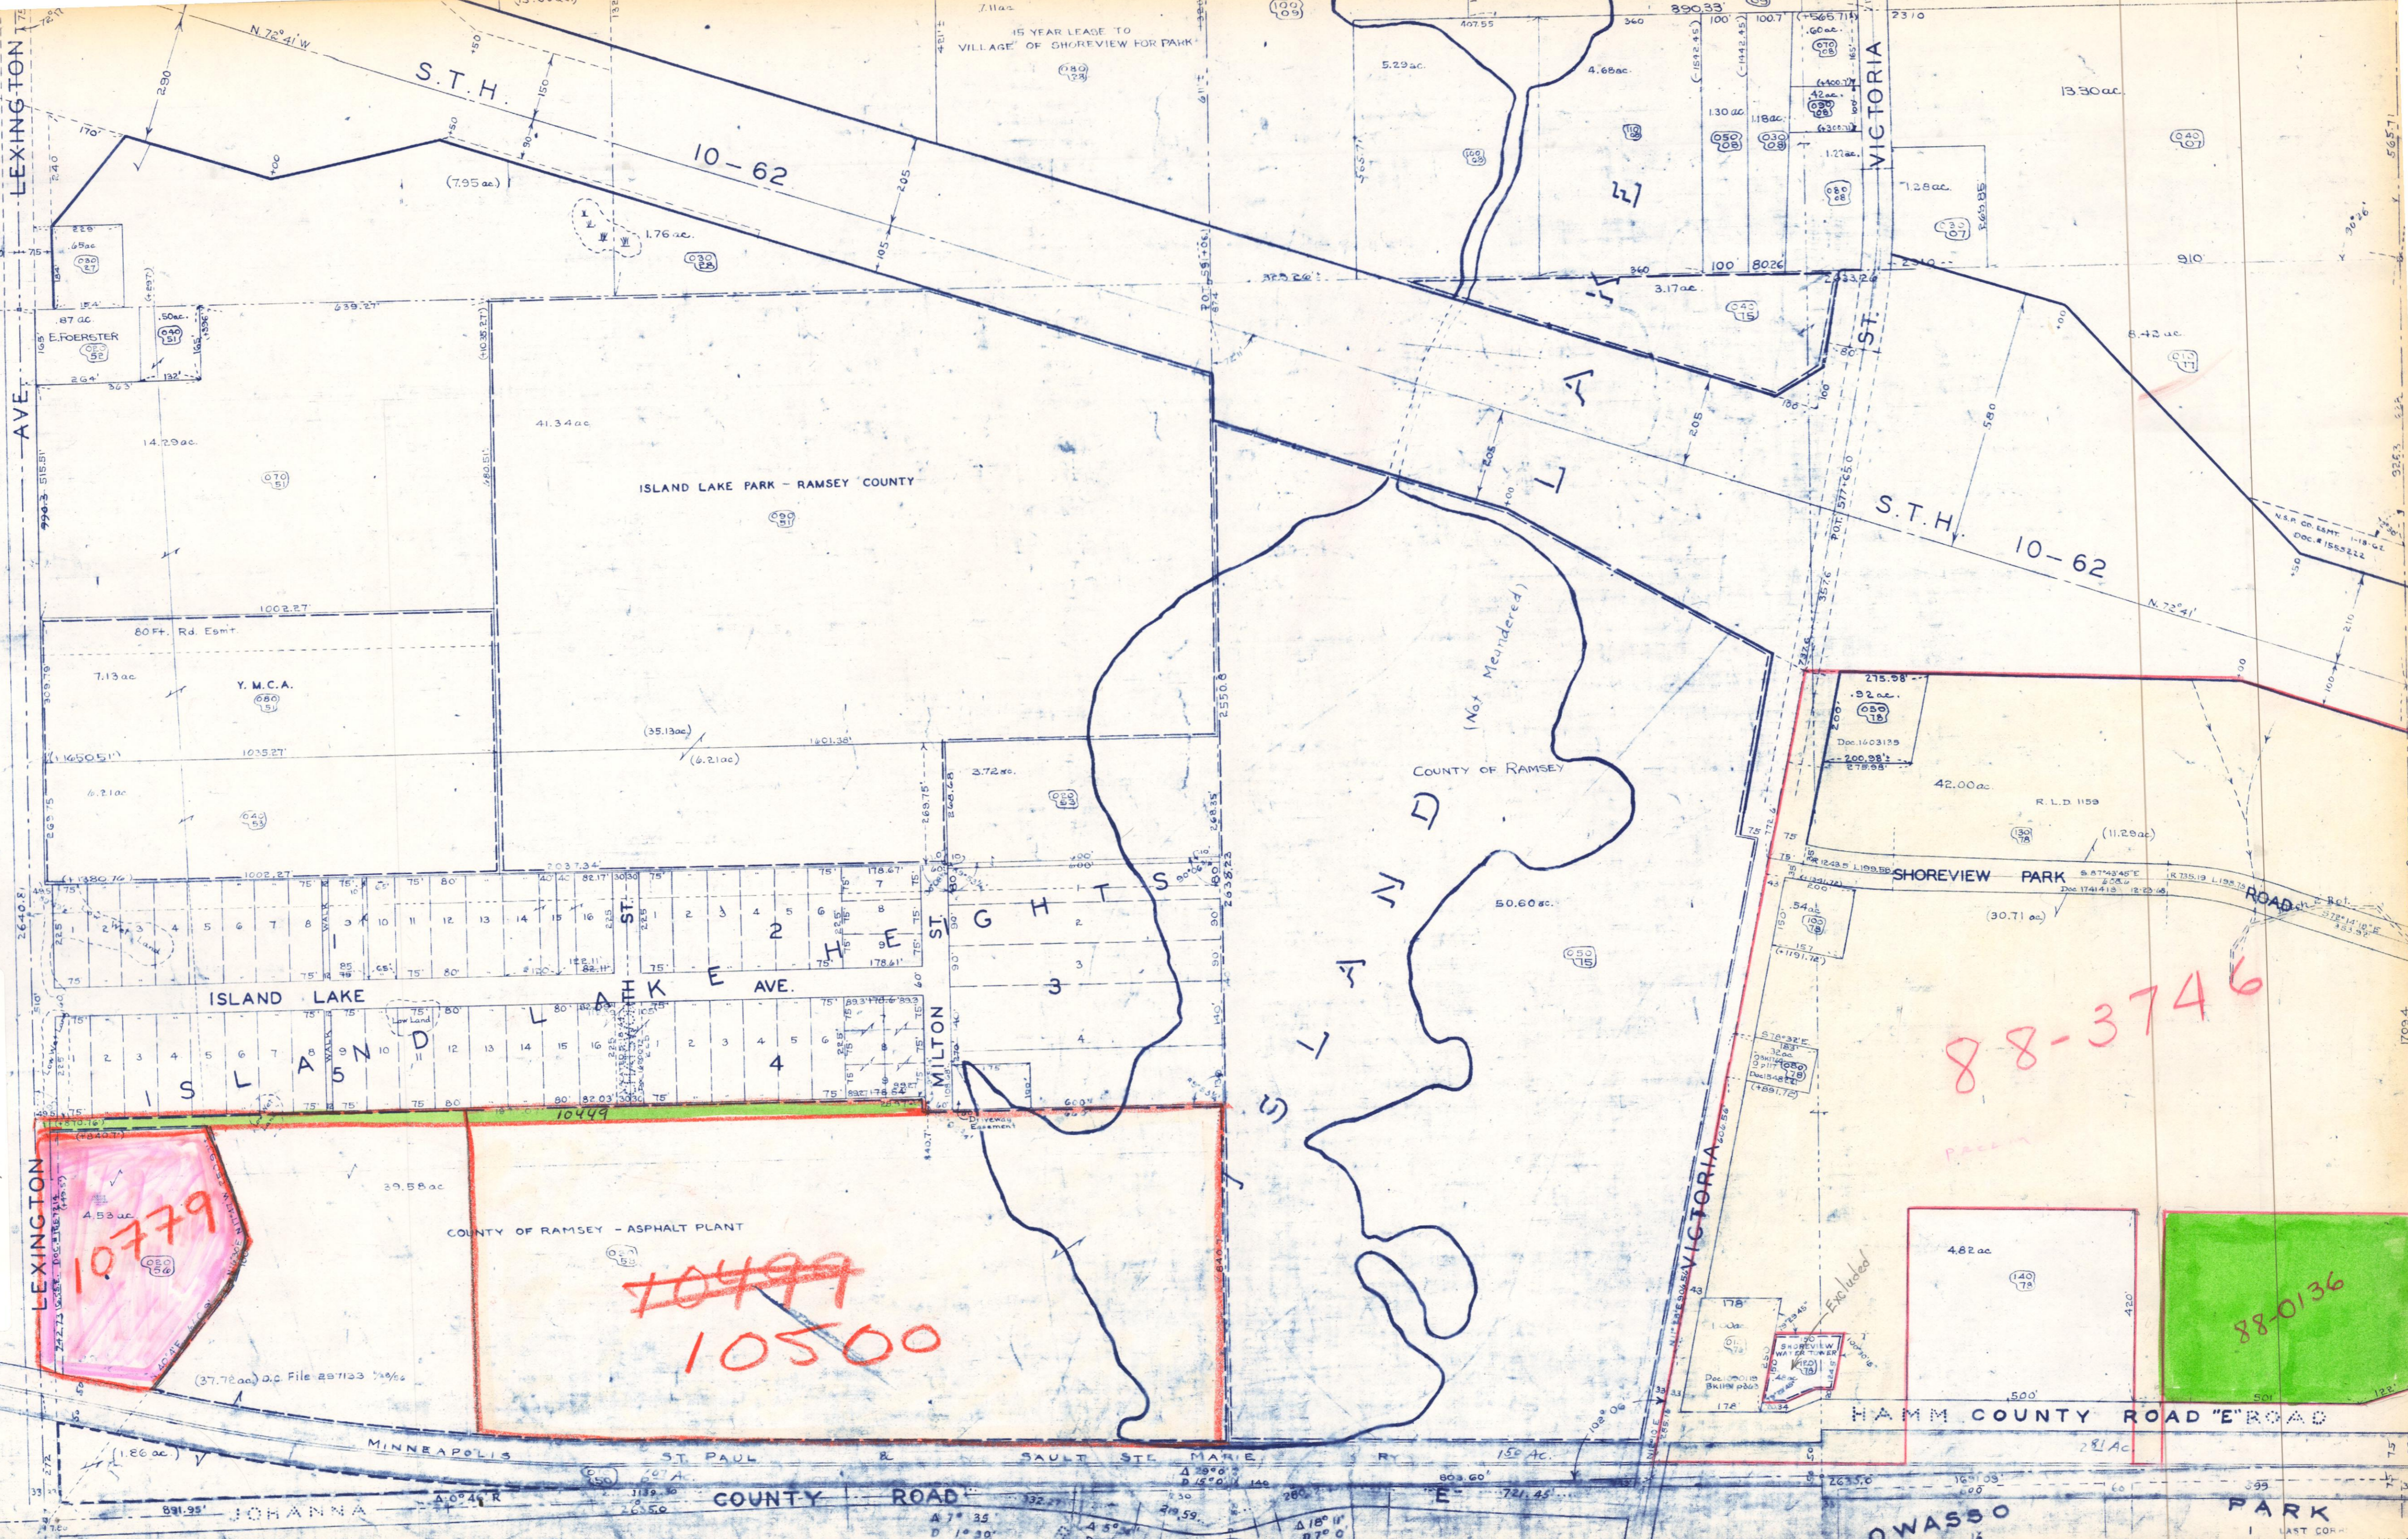

26-30-23
5/8

88-3746

88-0136

10779

10499
10500

26-30-23

35

AREAS & DIMENSIONS
SUBJECT TO CHANGE