


30

28

32

29-30-23

29-30-23
5/2

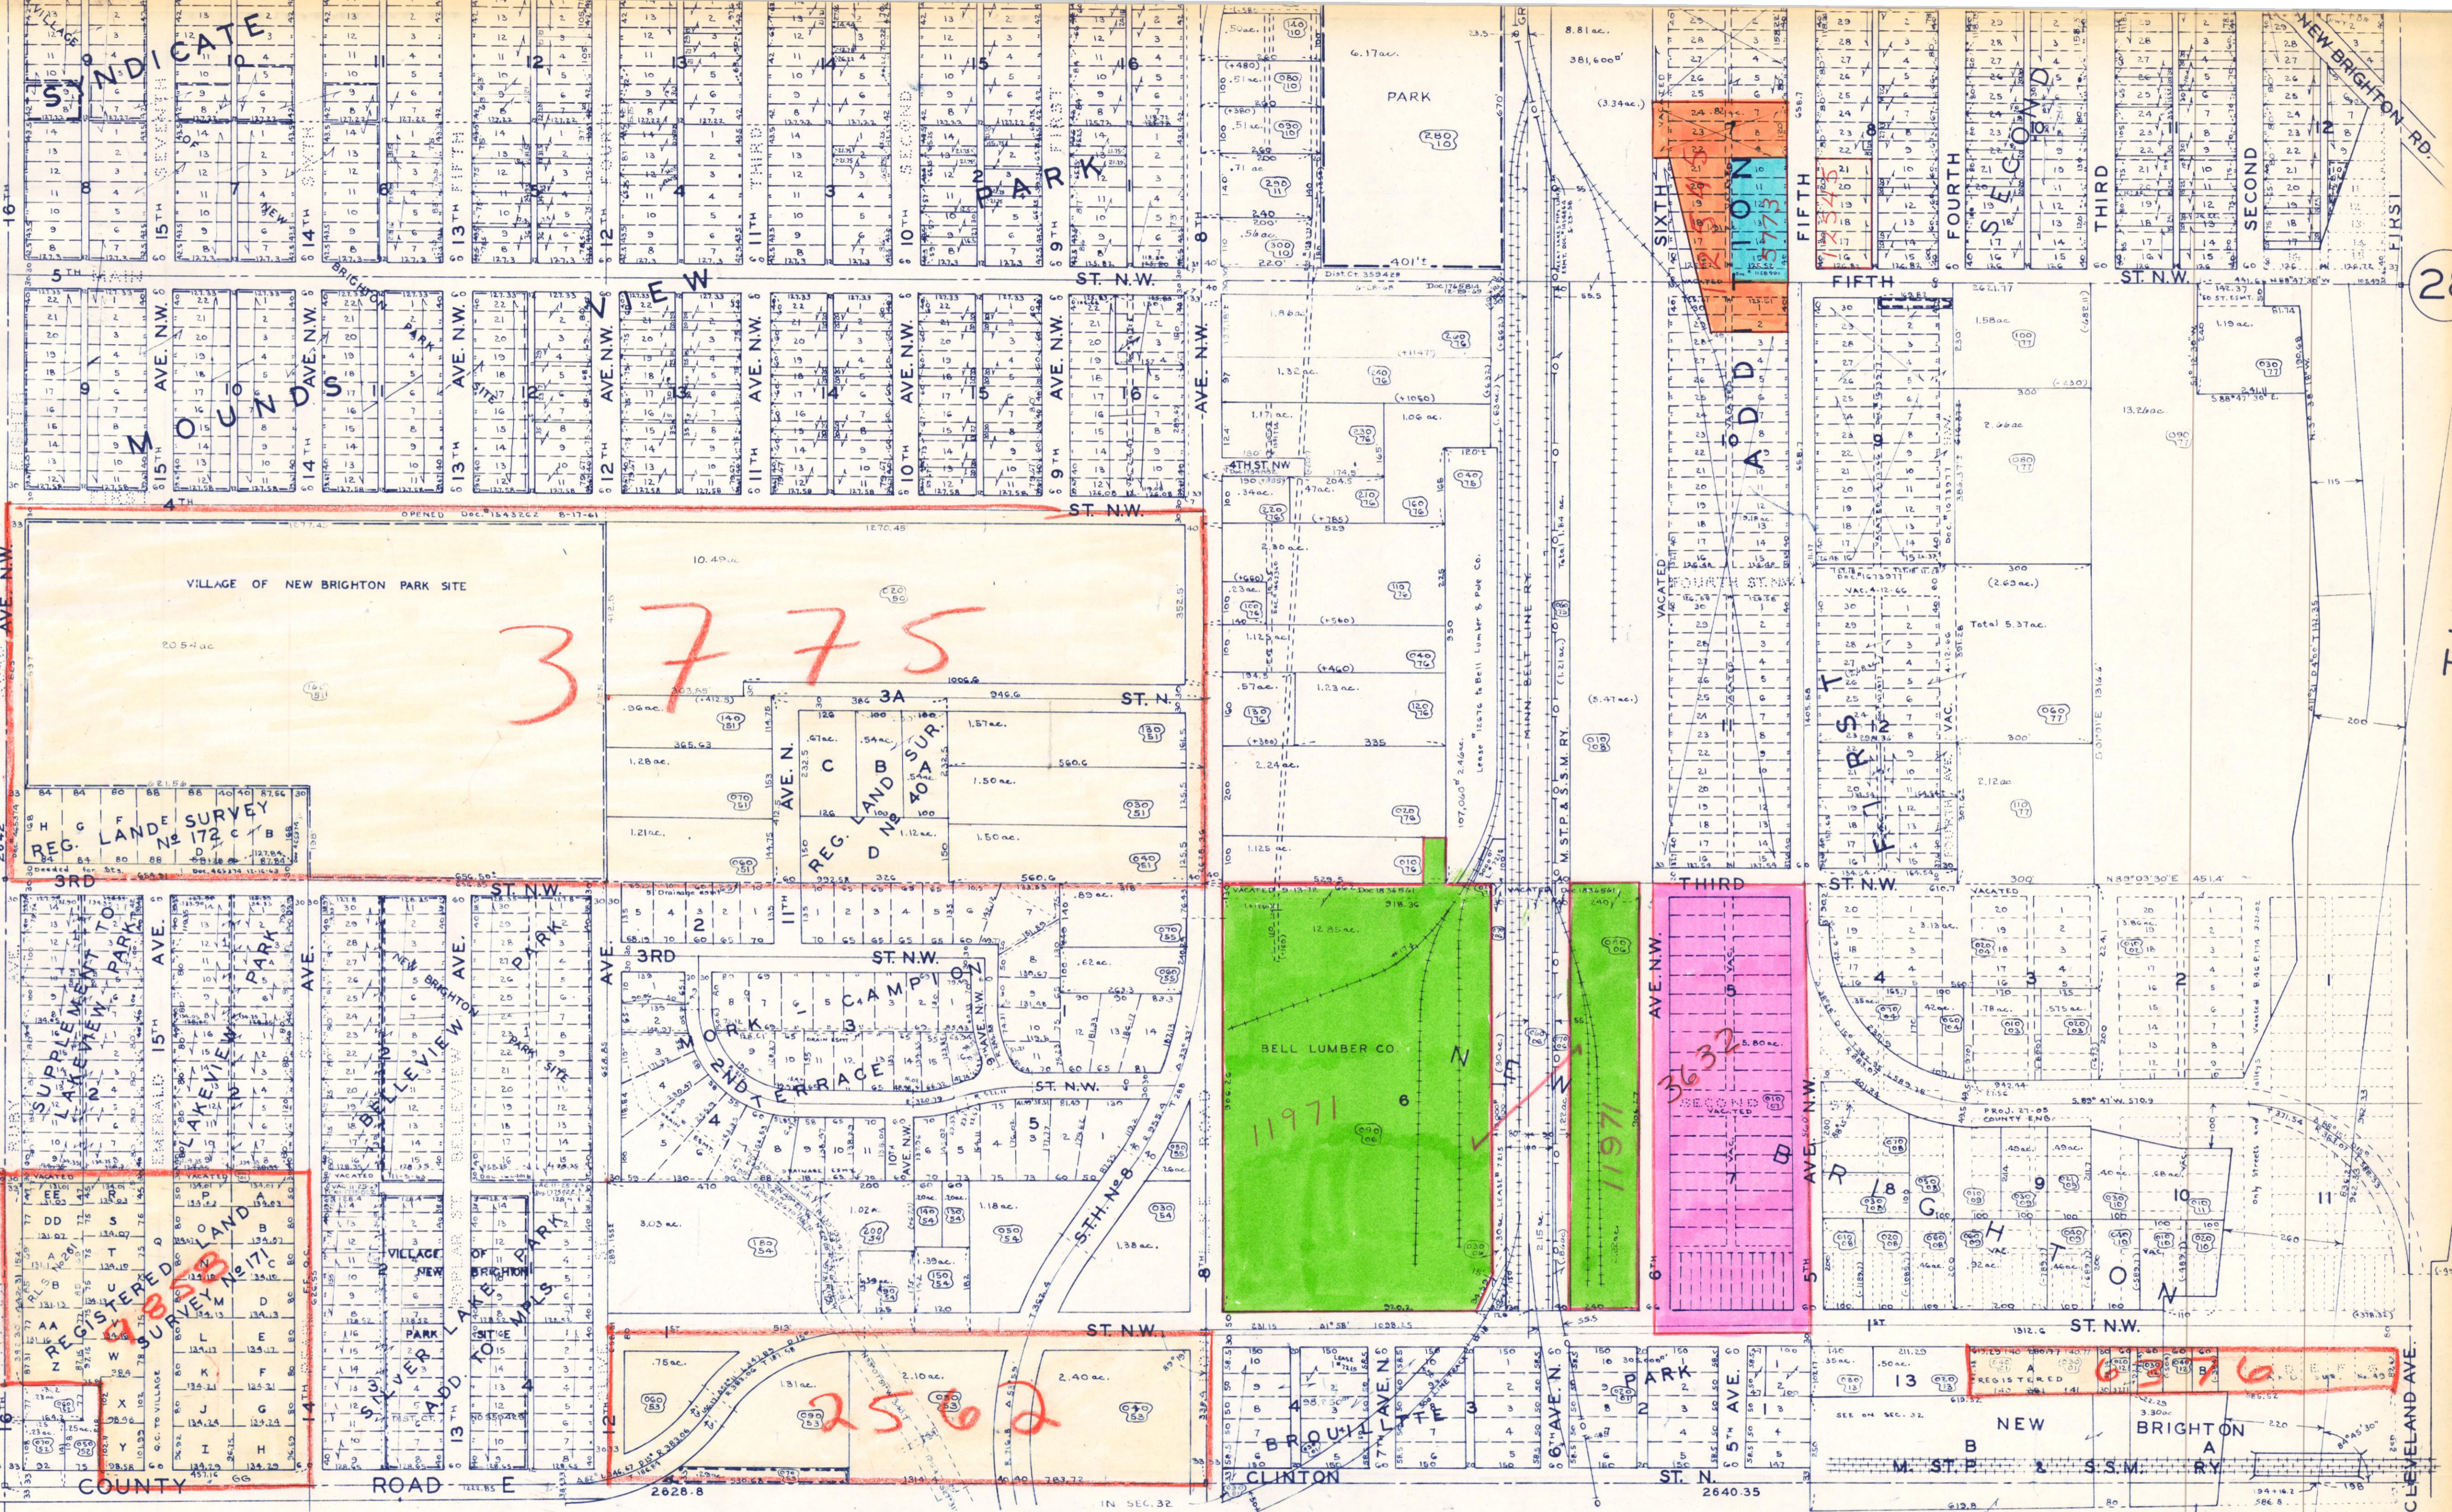

DEPARTMENT OF ASSESSOR
 RAMSEY COUNTY
 SCALE 1" = 200'
 R.G.G. 2-16-87