


32

34

33-30-23
South 1/2

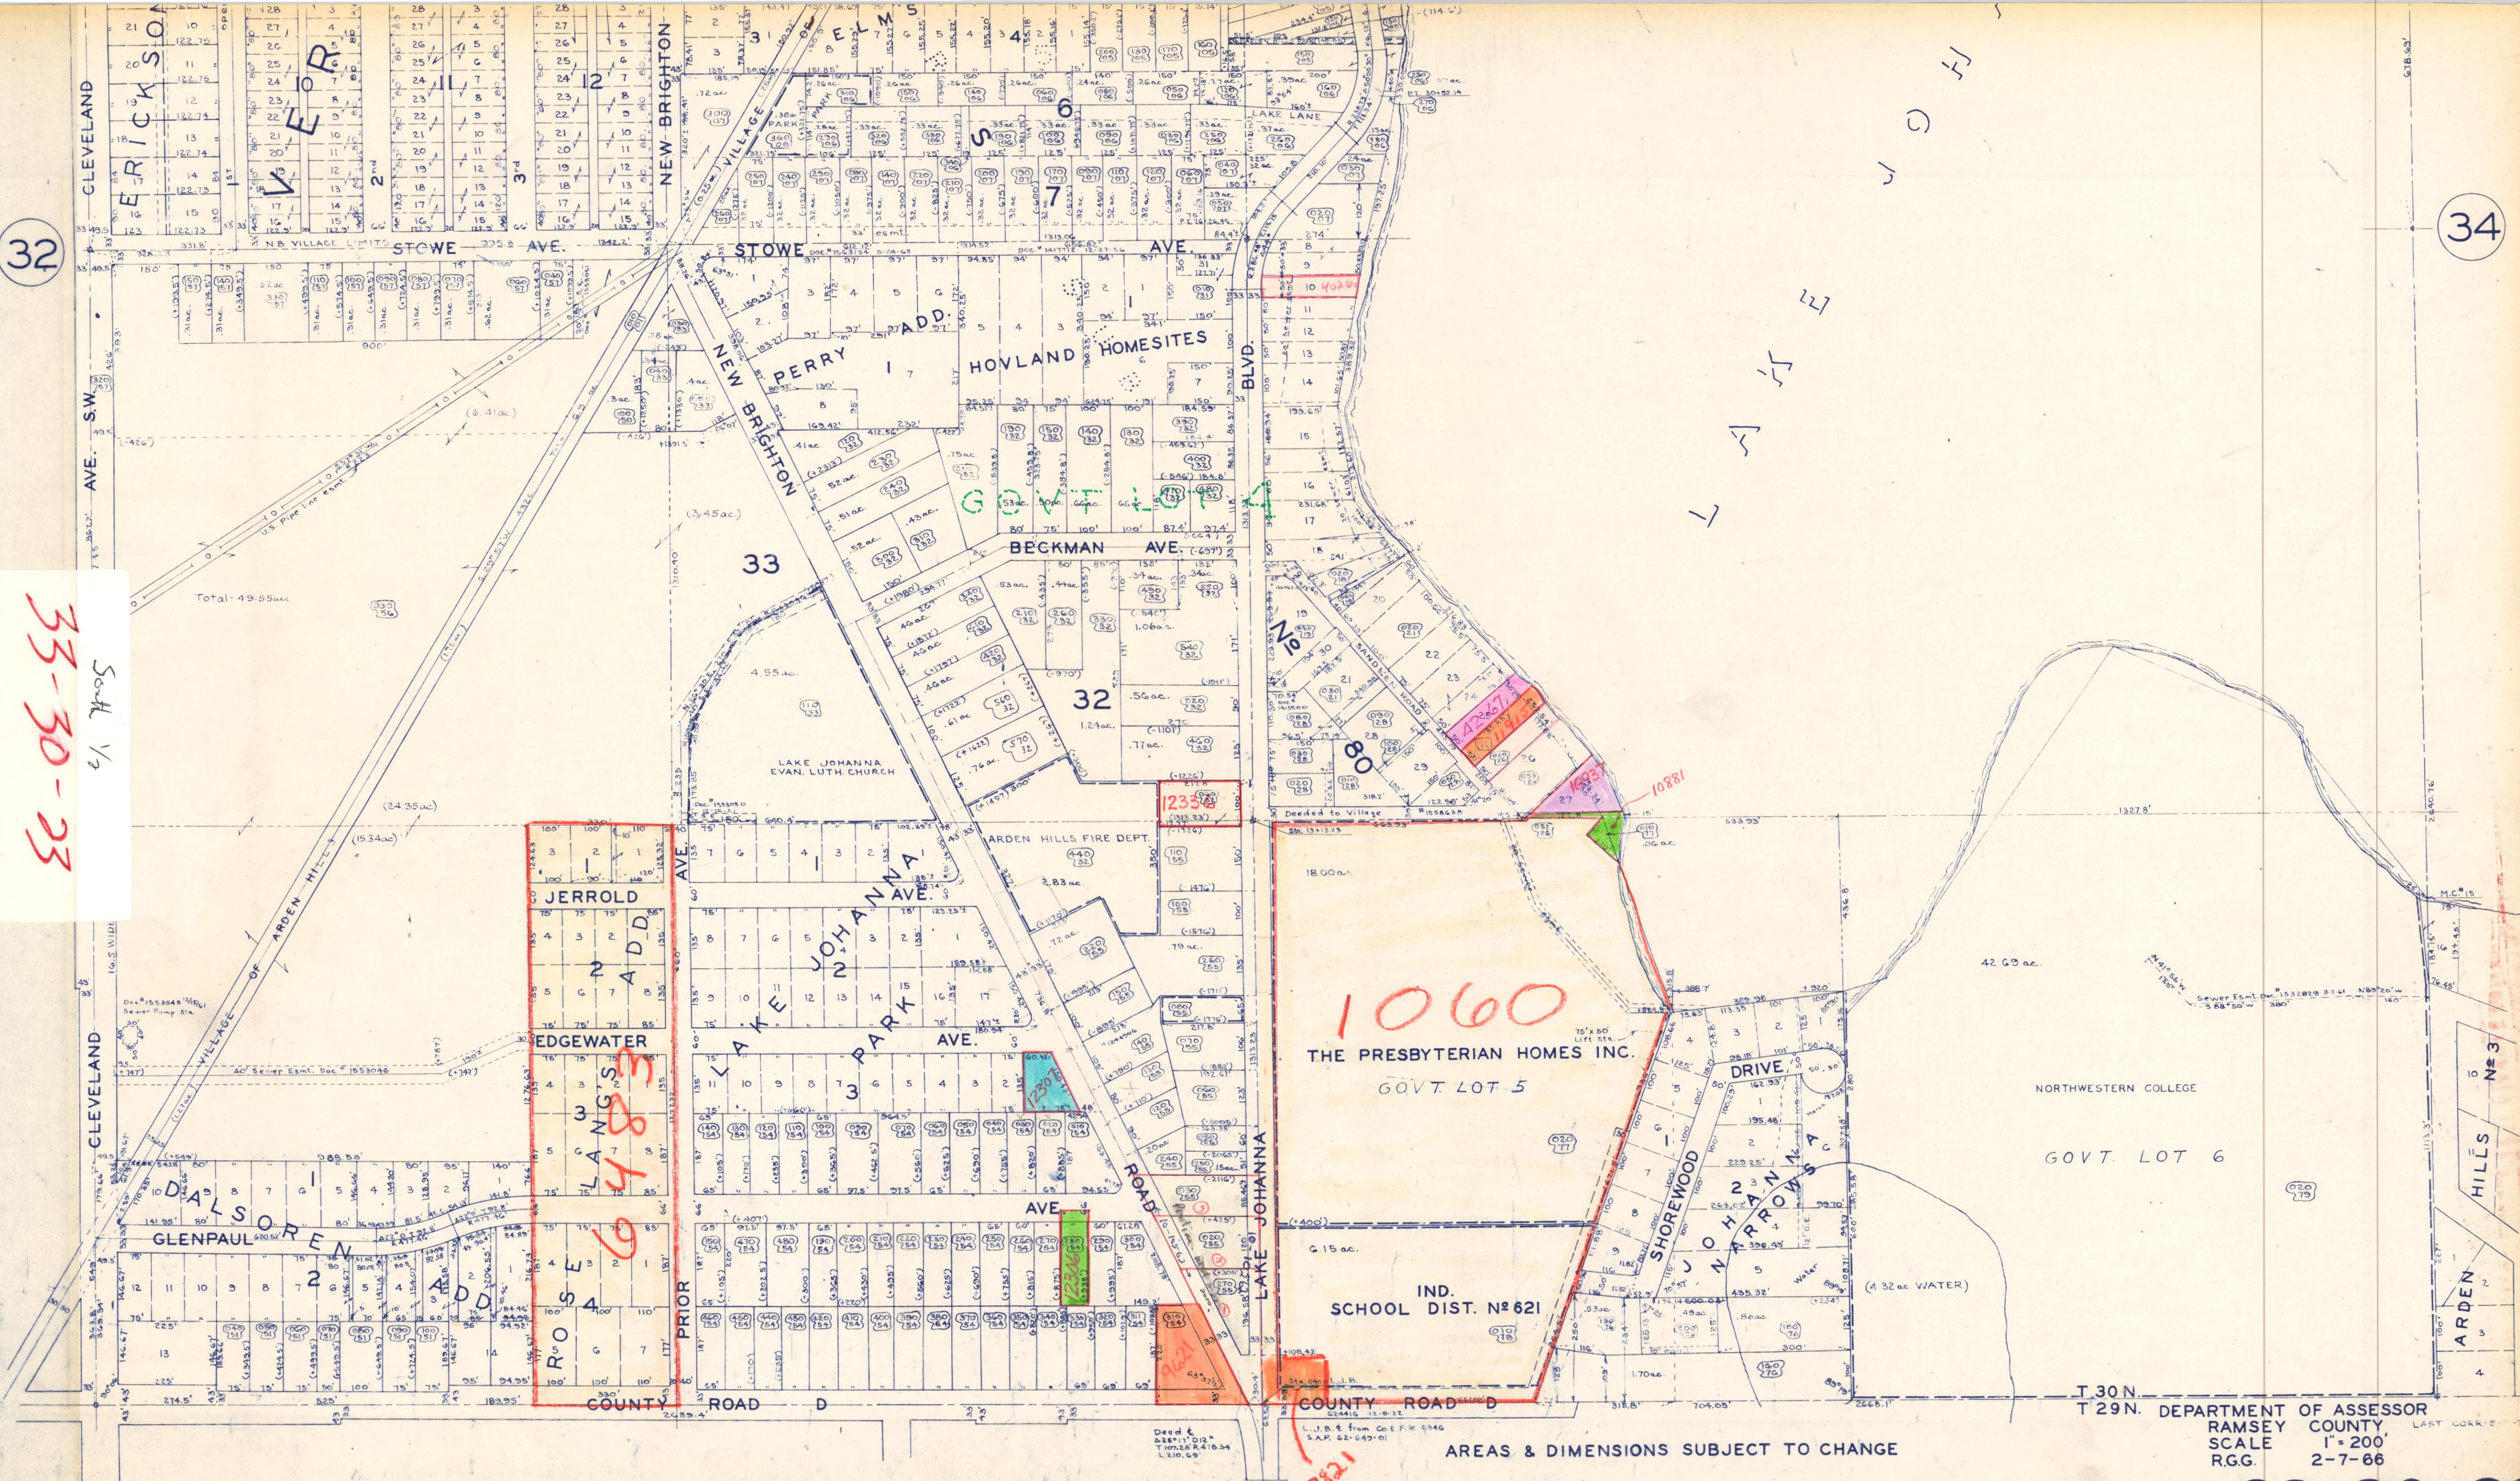

AREAS & DIMENSIONS SUBJECT TO CHANGE

T 30 N.
T 29 N. DEPARTMENT OF ASSESSOR
RAMSEY COUNTY
SCALE 1" = 200'
R.G.G. 2-7-66

33 30 23

4