


35

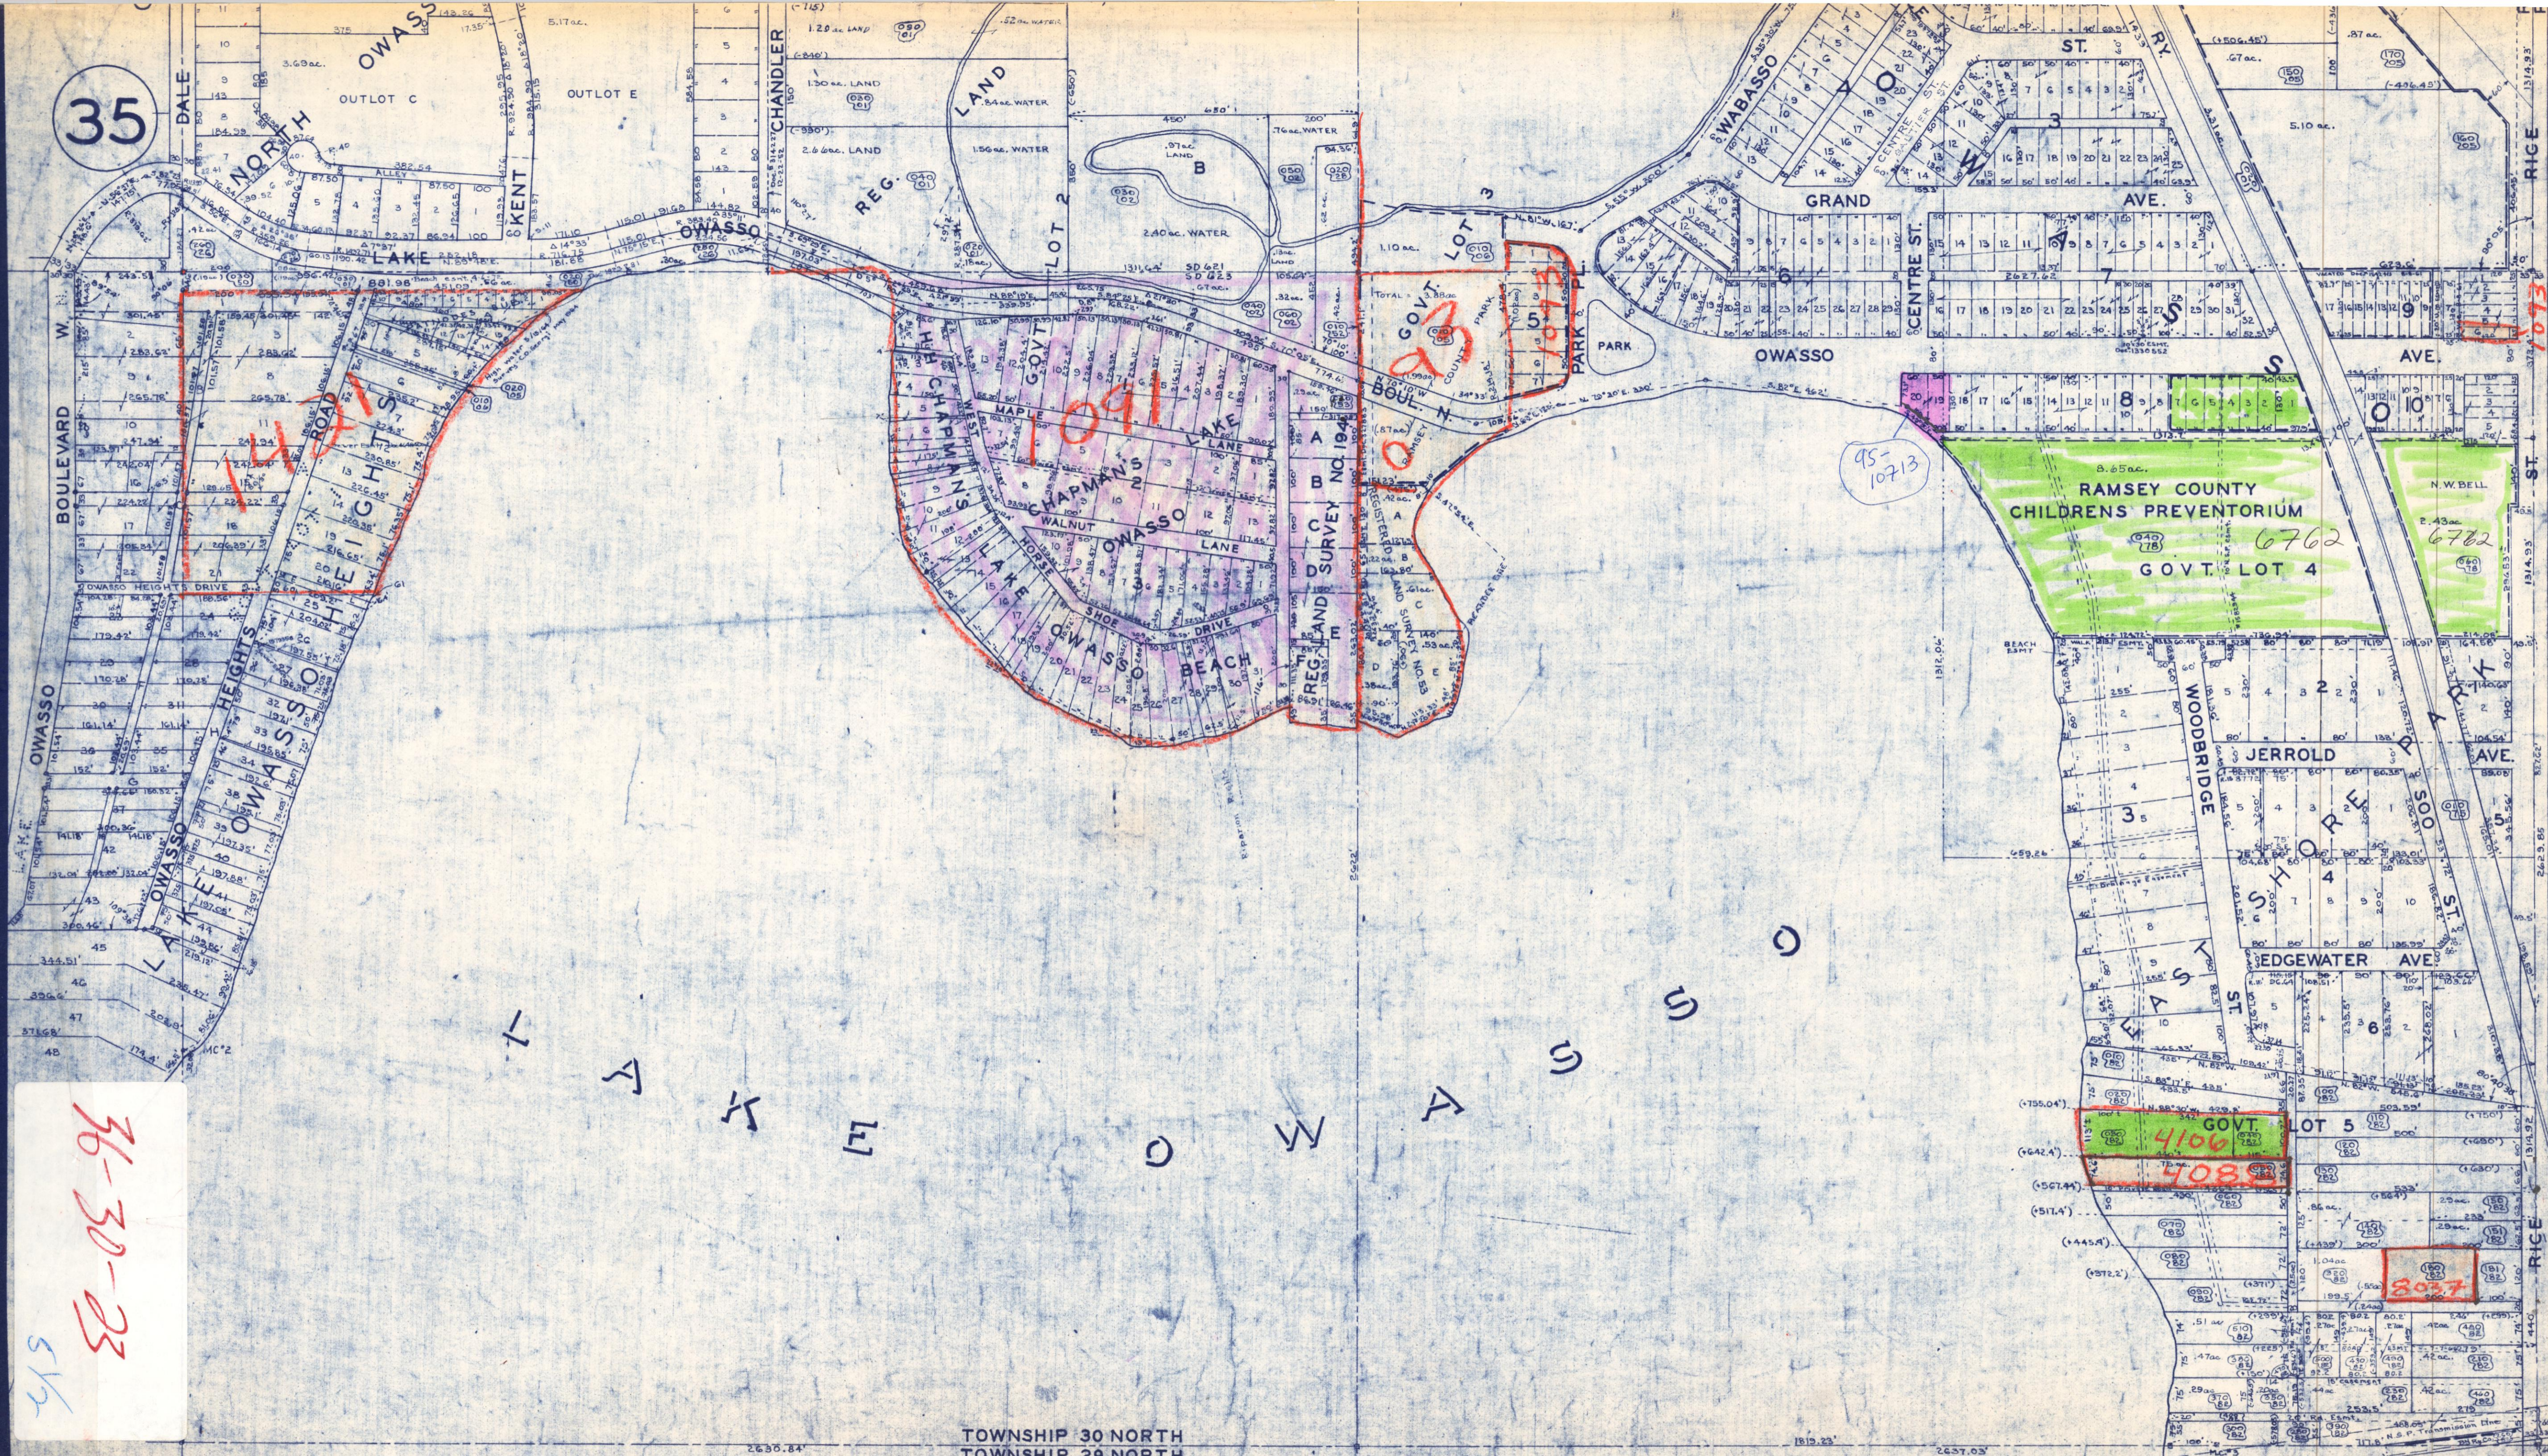

36-30-23
 5/12

36-30-23

TOWNSHIP 30 NORTH
 TOWNSHIP 29 NORTH

AREAS & DIMENSIONS SUBJECT TO CHANGE

1

DEPARTMENT OF ASSESSOR
 RAMSEY COUNTY
 R.G.G. 12-13-65
 SCALE 1"=200'