


S.E. 1/4, Sec. 2-28-22

* Lot 11, Block 3 Afton Heights
slb green. Court File # 9036

Lot 16, 1 court file #
not supposed to have purple
outline.

DAYTON & WARREN'S PROSPECT ADDITION

3818
Battle Creek Playgrounds

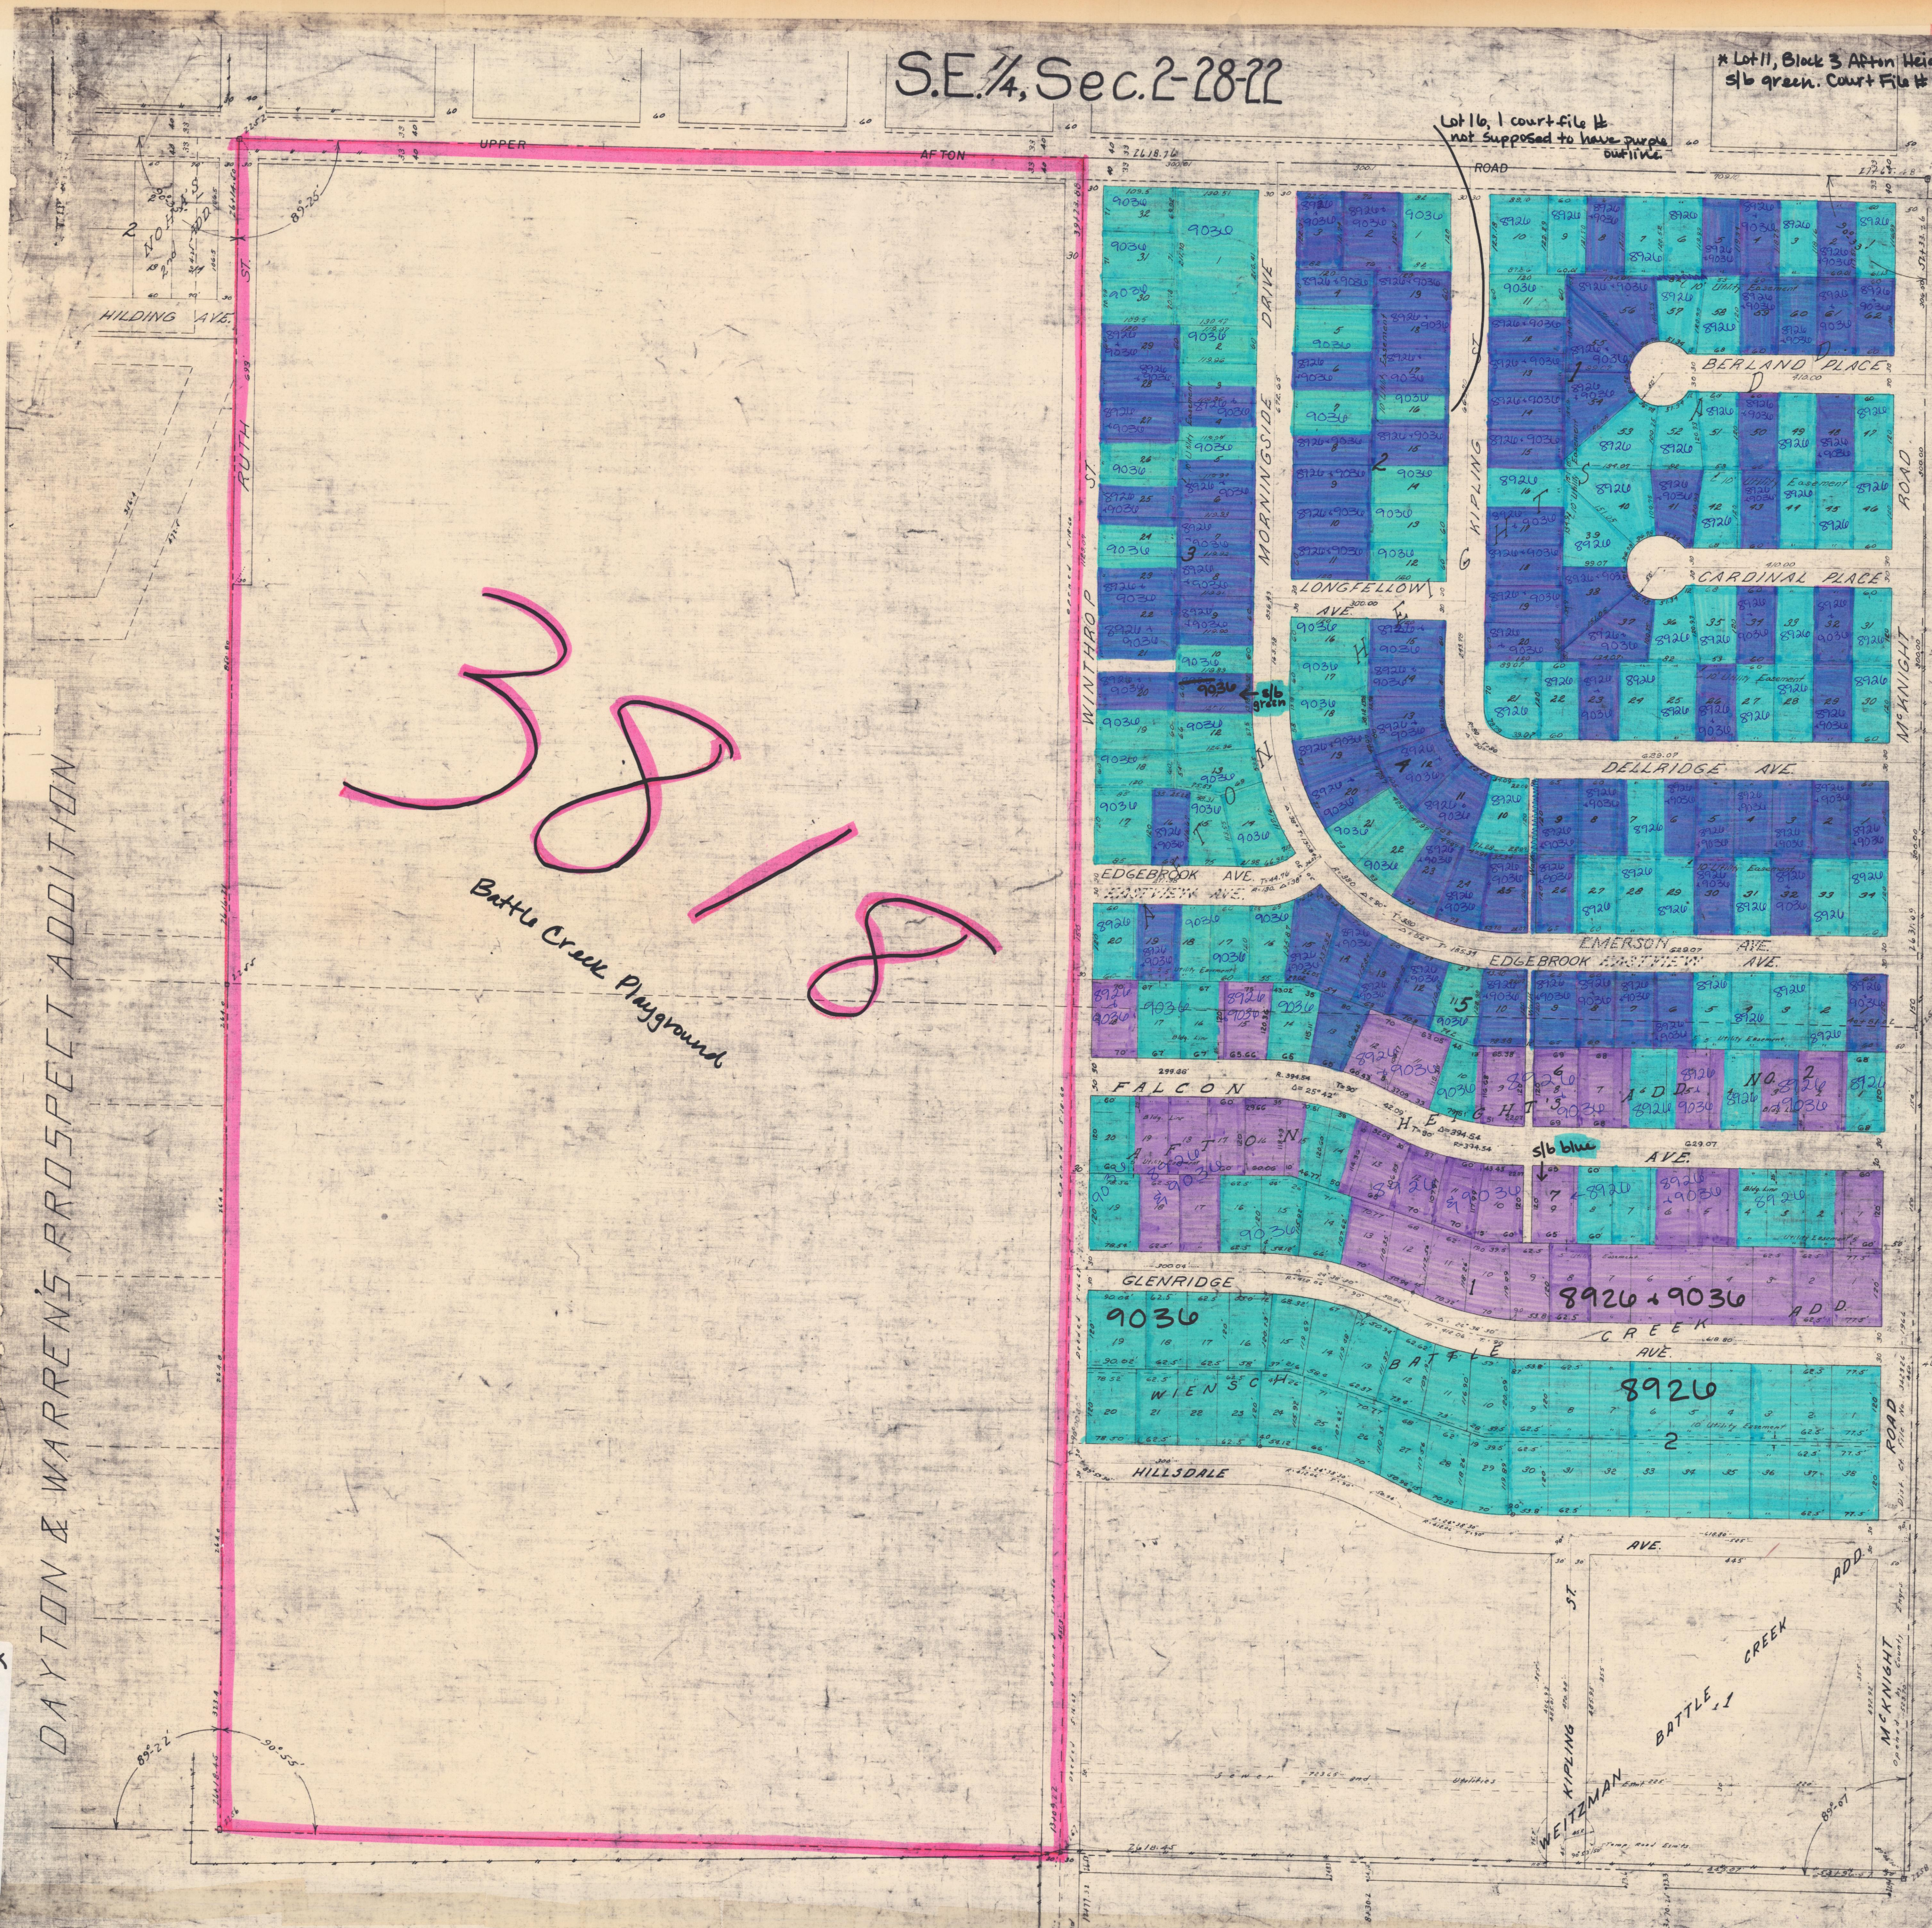

SE 1/4
2-28-22