


S.E. 1/4 Sec. 3, 28-22.

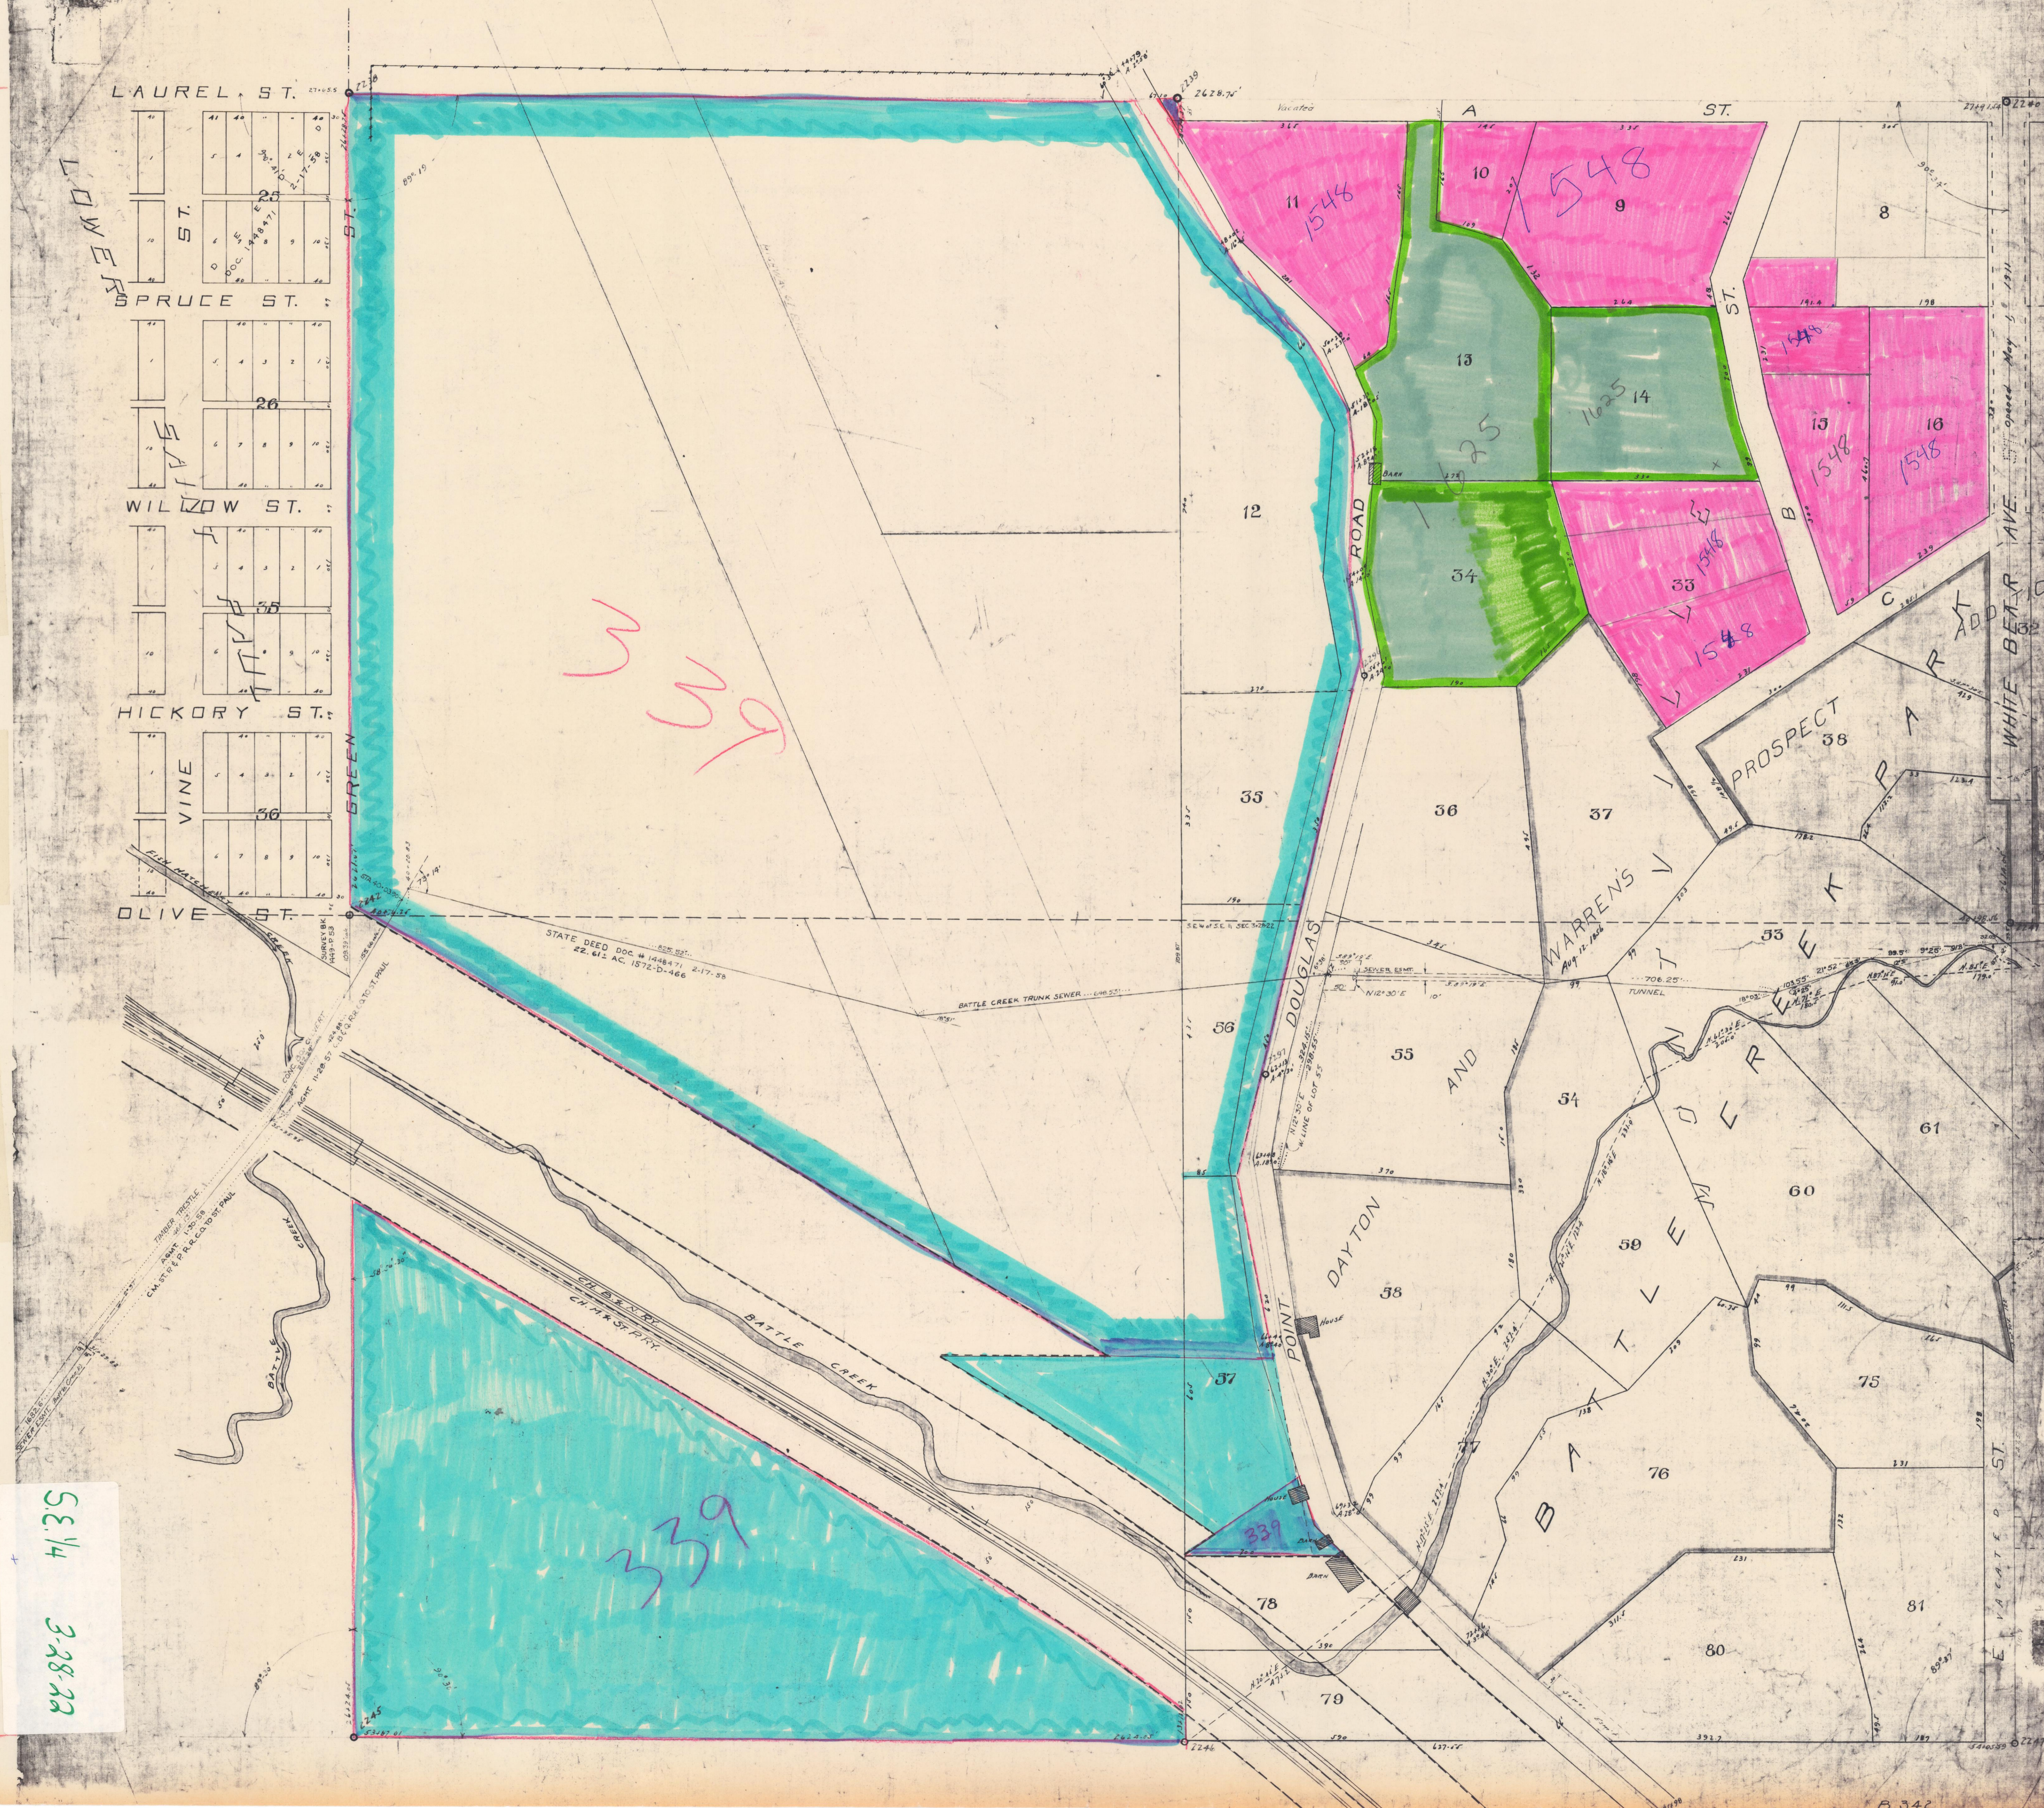

S.E. 1/4
28-22

339

339

PROSPECT 38

DAYTON

BATTLE

WHITE BEAR AVE

ELM ST