


SE 1/4 SEC. 9-28-22

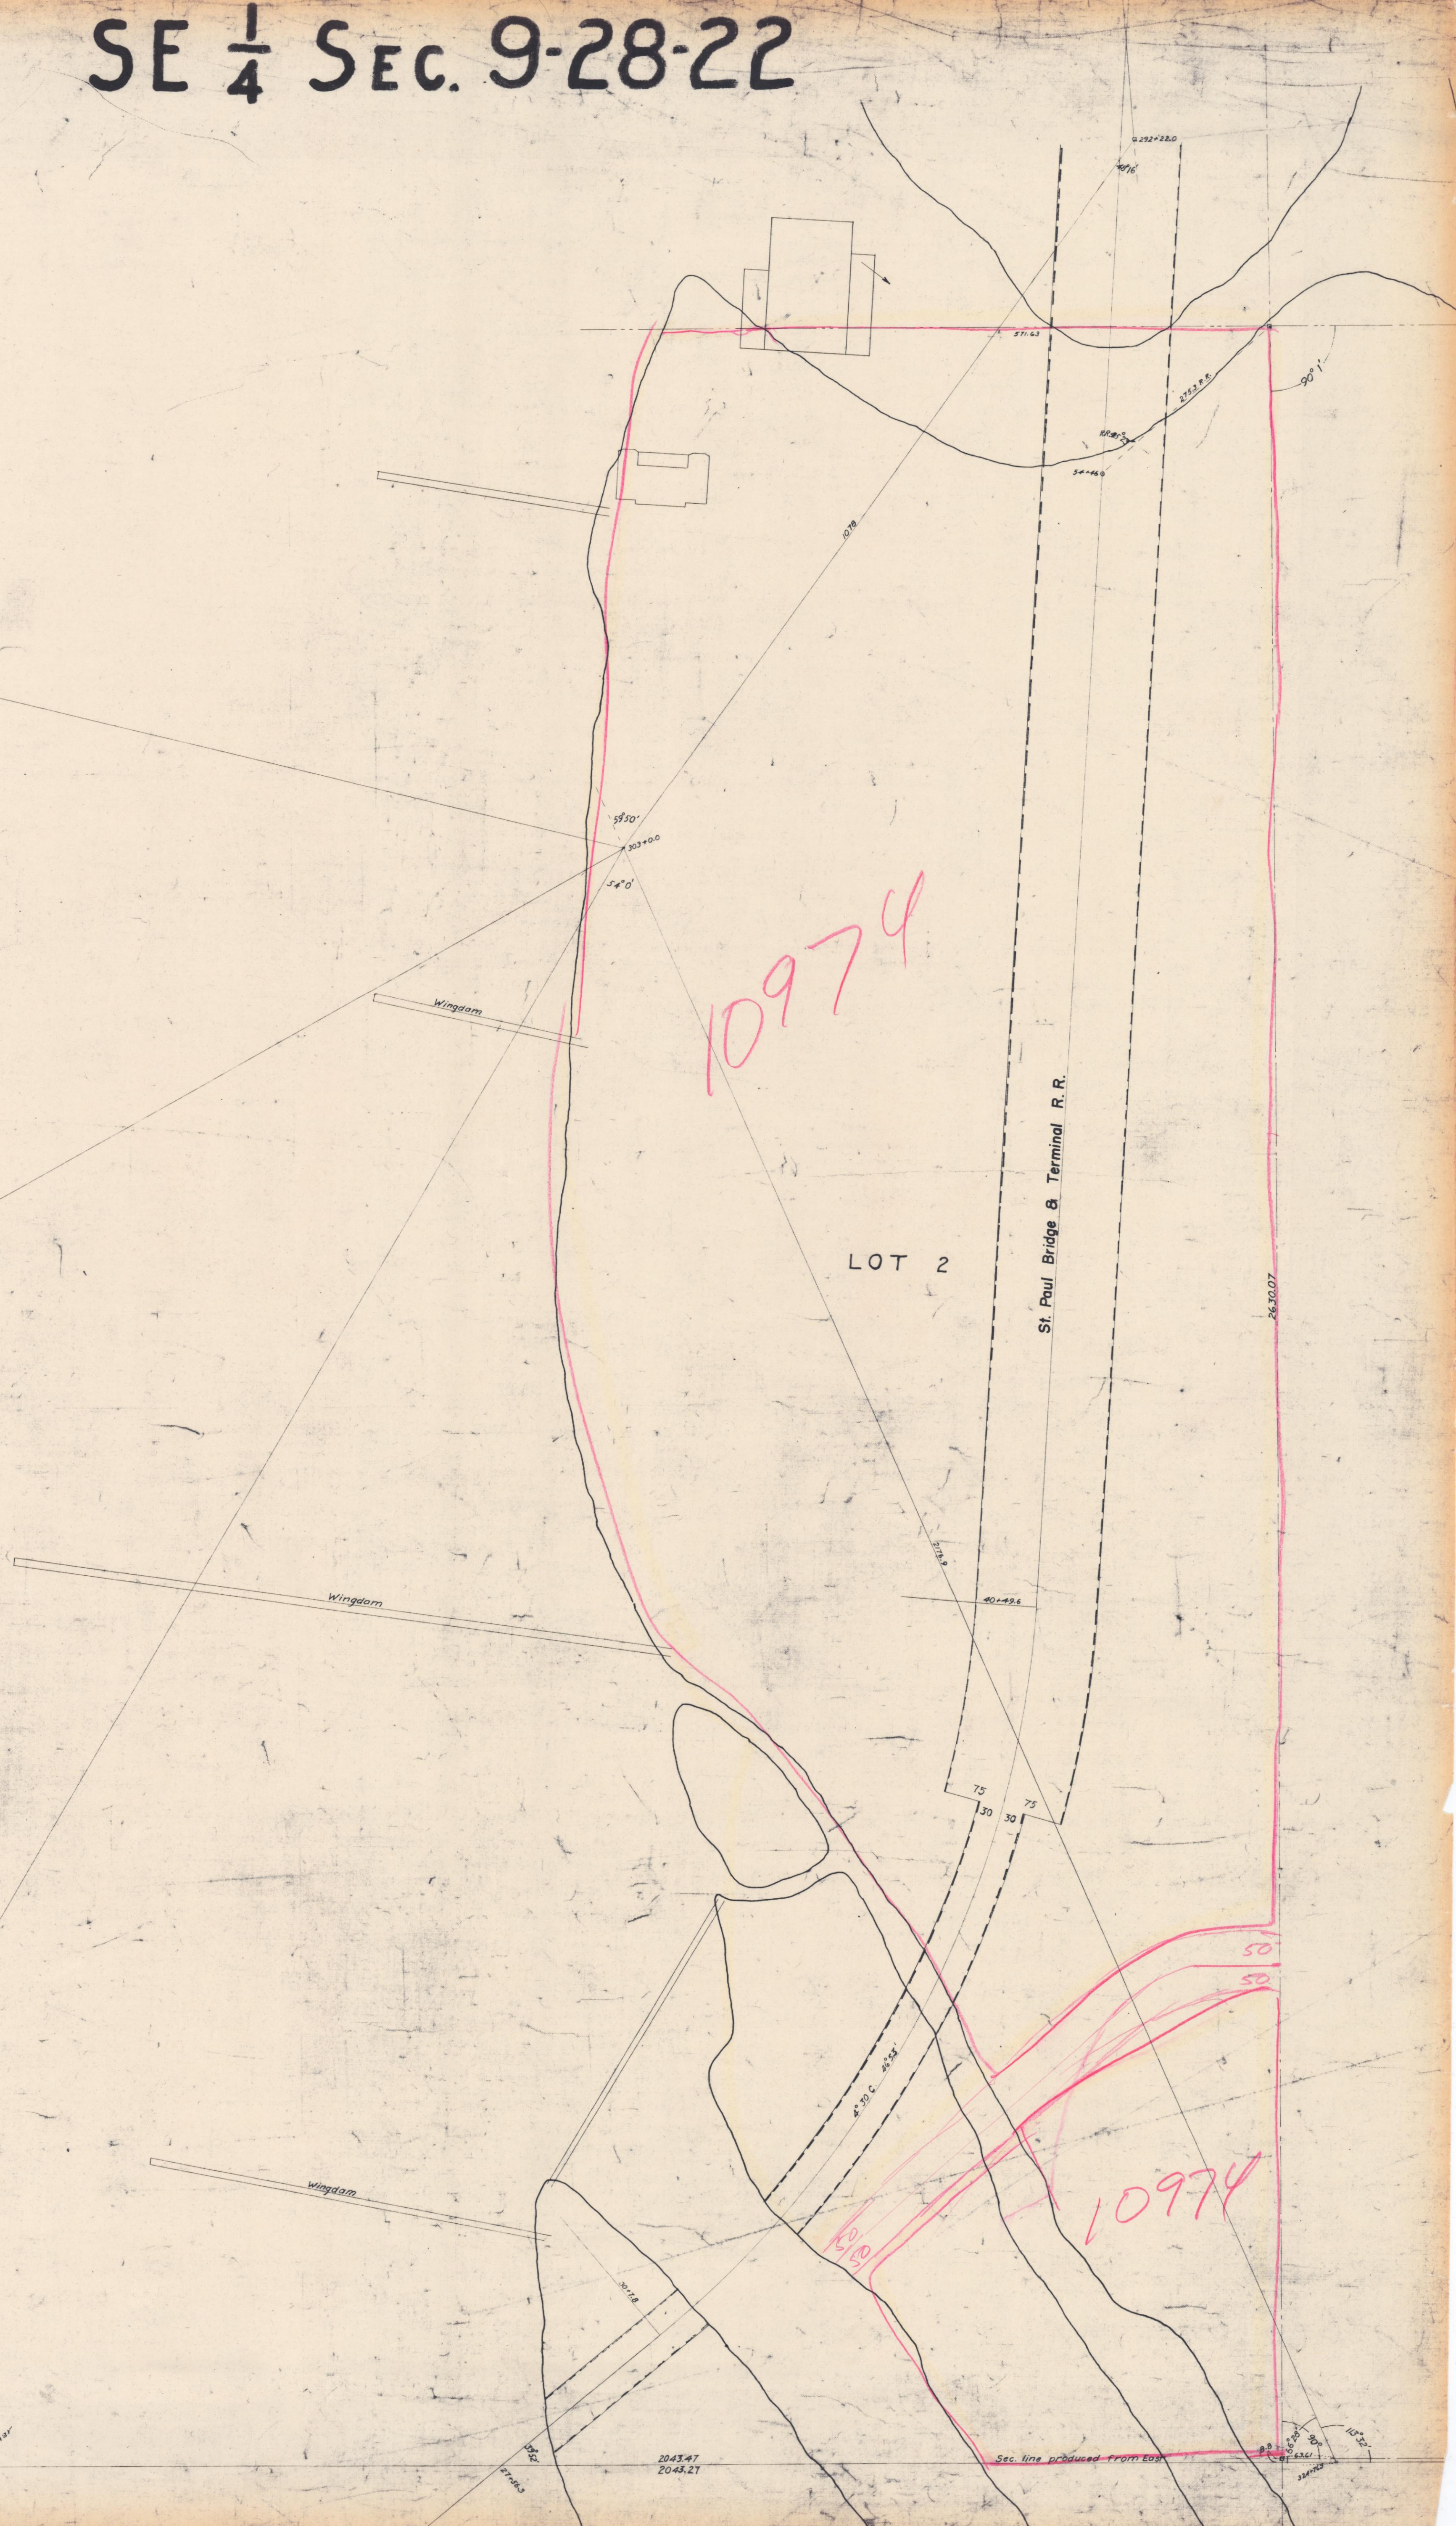

Book 324

SE 1/4 9-28-22 *



