


S. E. 1/4 Sec. 17—28-23

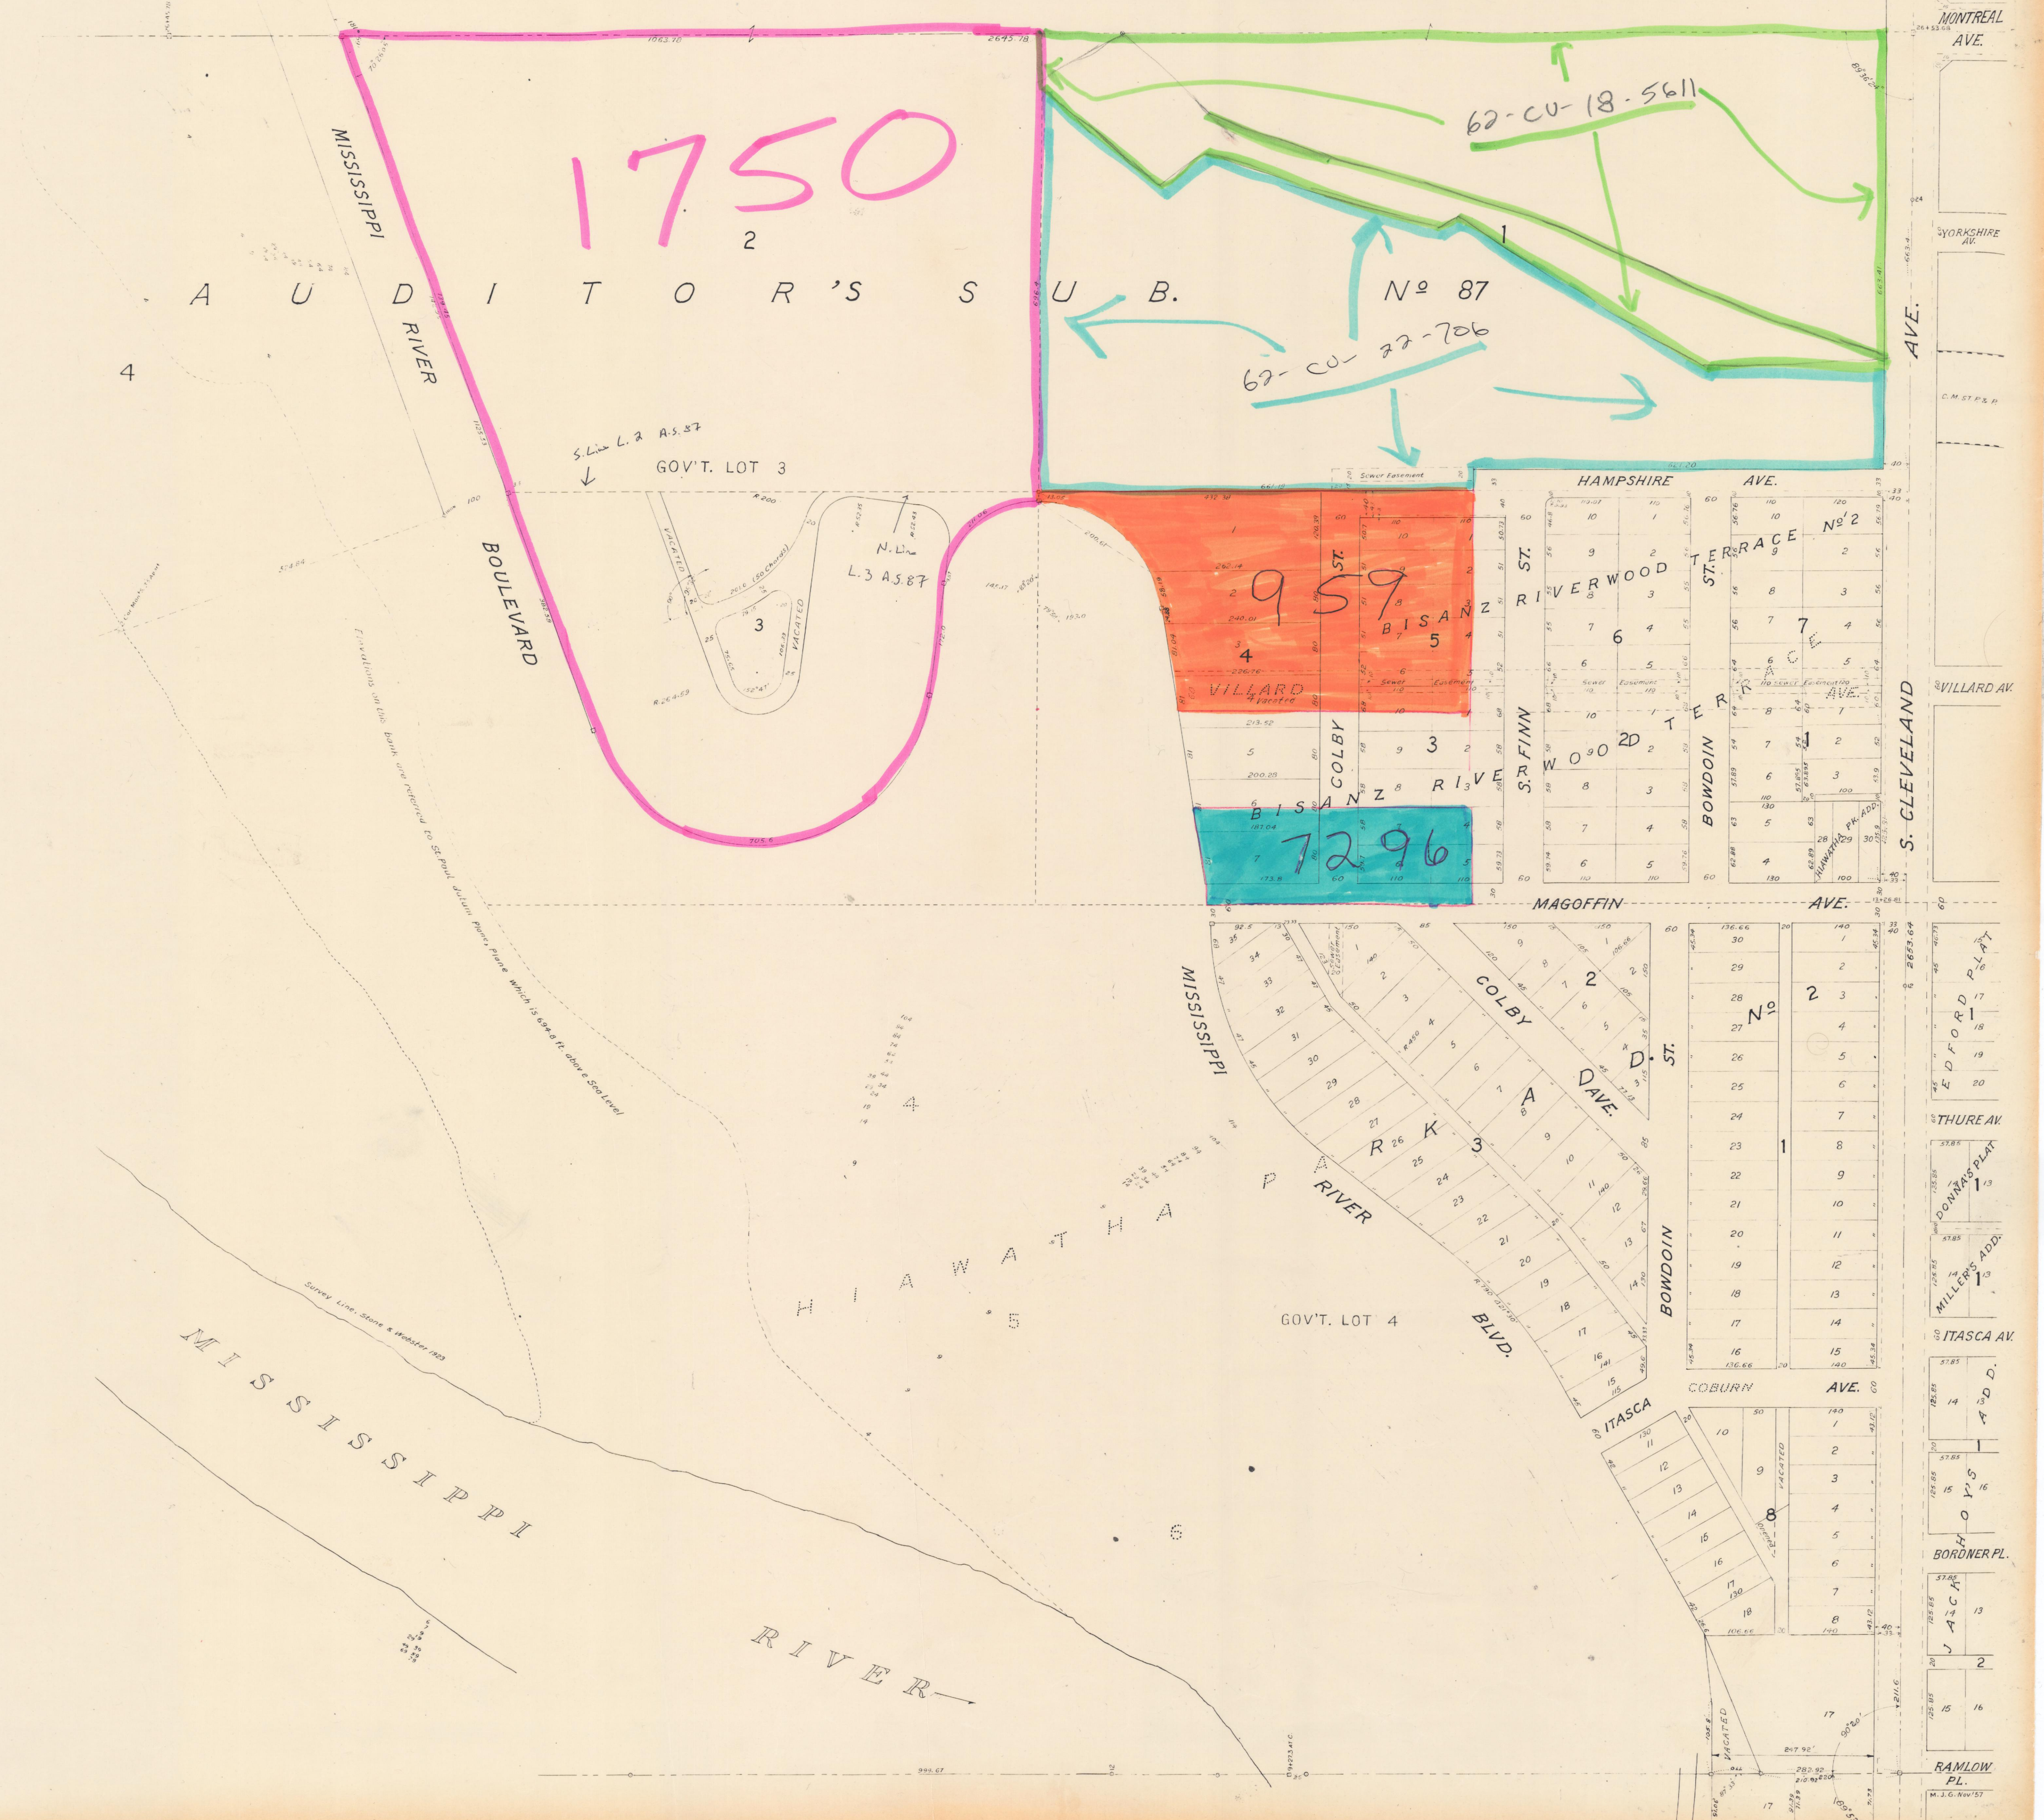

1750

62-CU-18-5611
62-CU-72-706
No 87

959
VILLARD
BISANZ

7296
BISANZ
RIVER

S. Line L. 2 A.S. 57
GOV'T. LOT 3

L. 3 A.S. 87

GOV'T. LOT 4

S.E. 1/4 17-28-23