


S. E. 1/4 Sec. 21—29—22

LAKE

PHALEN

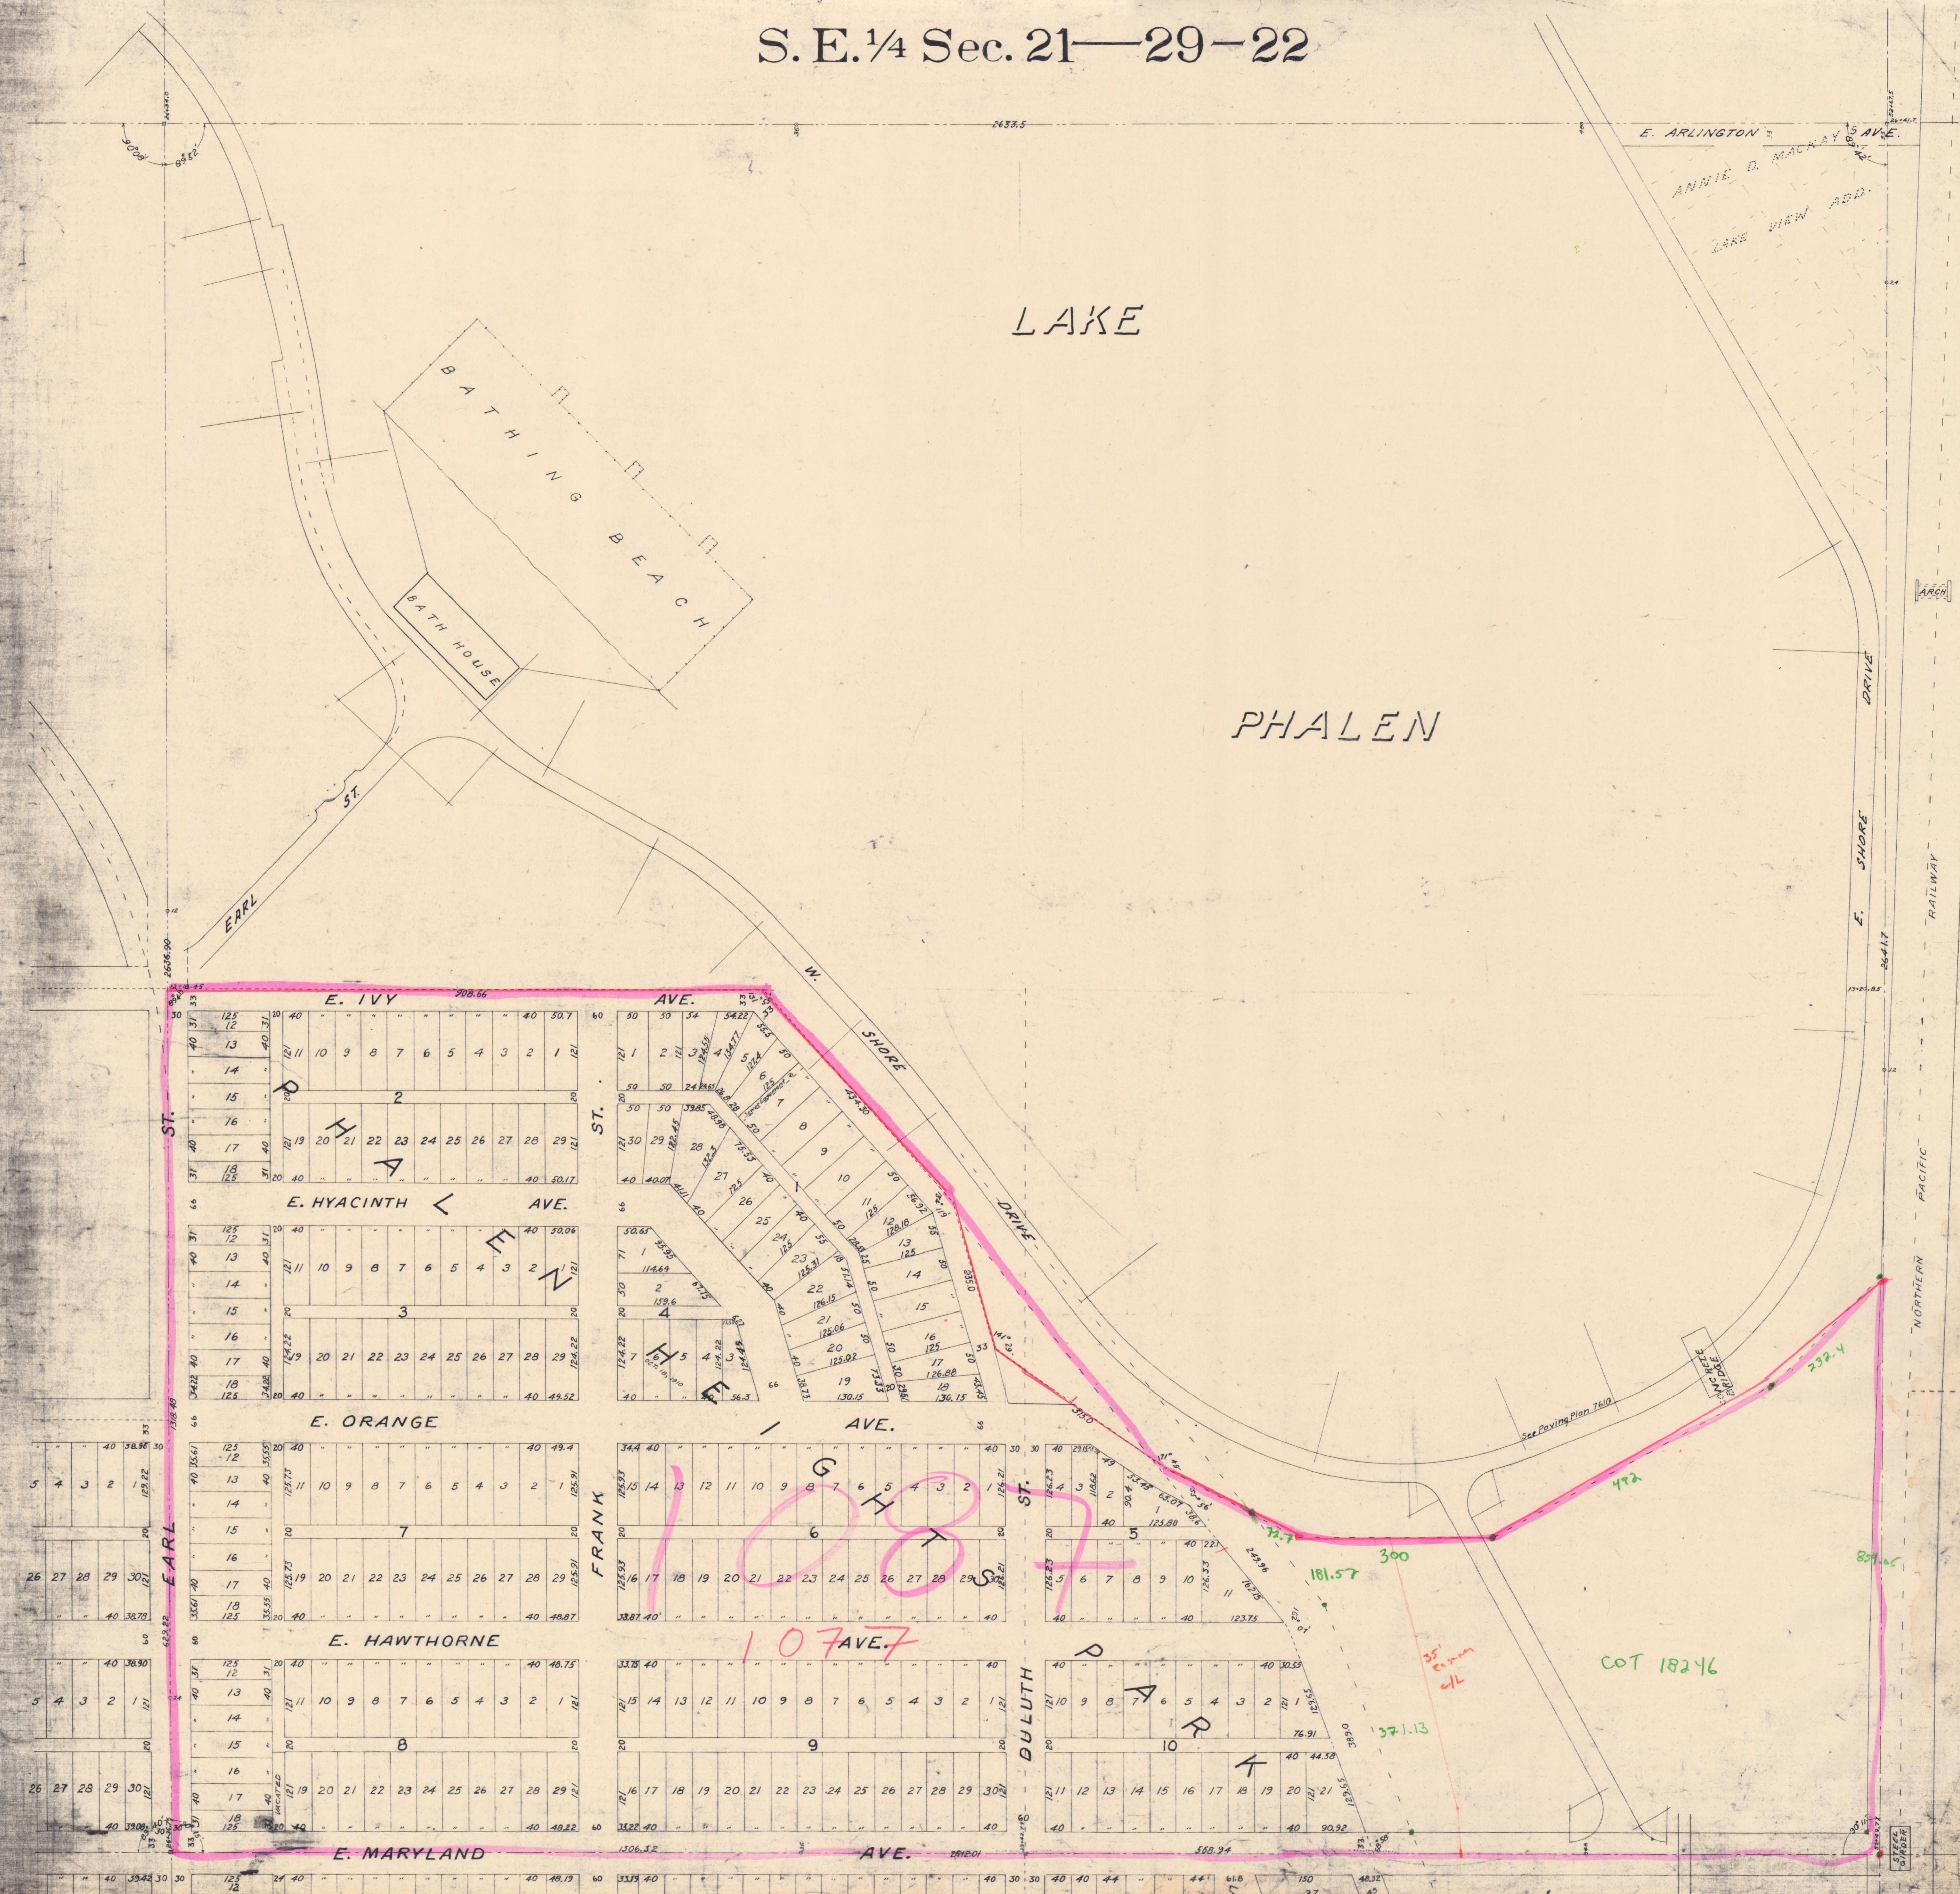

SE 1/4 21-29-22