


# S. E. 1/4 Sec. 35 — 29 — 22

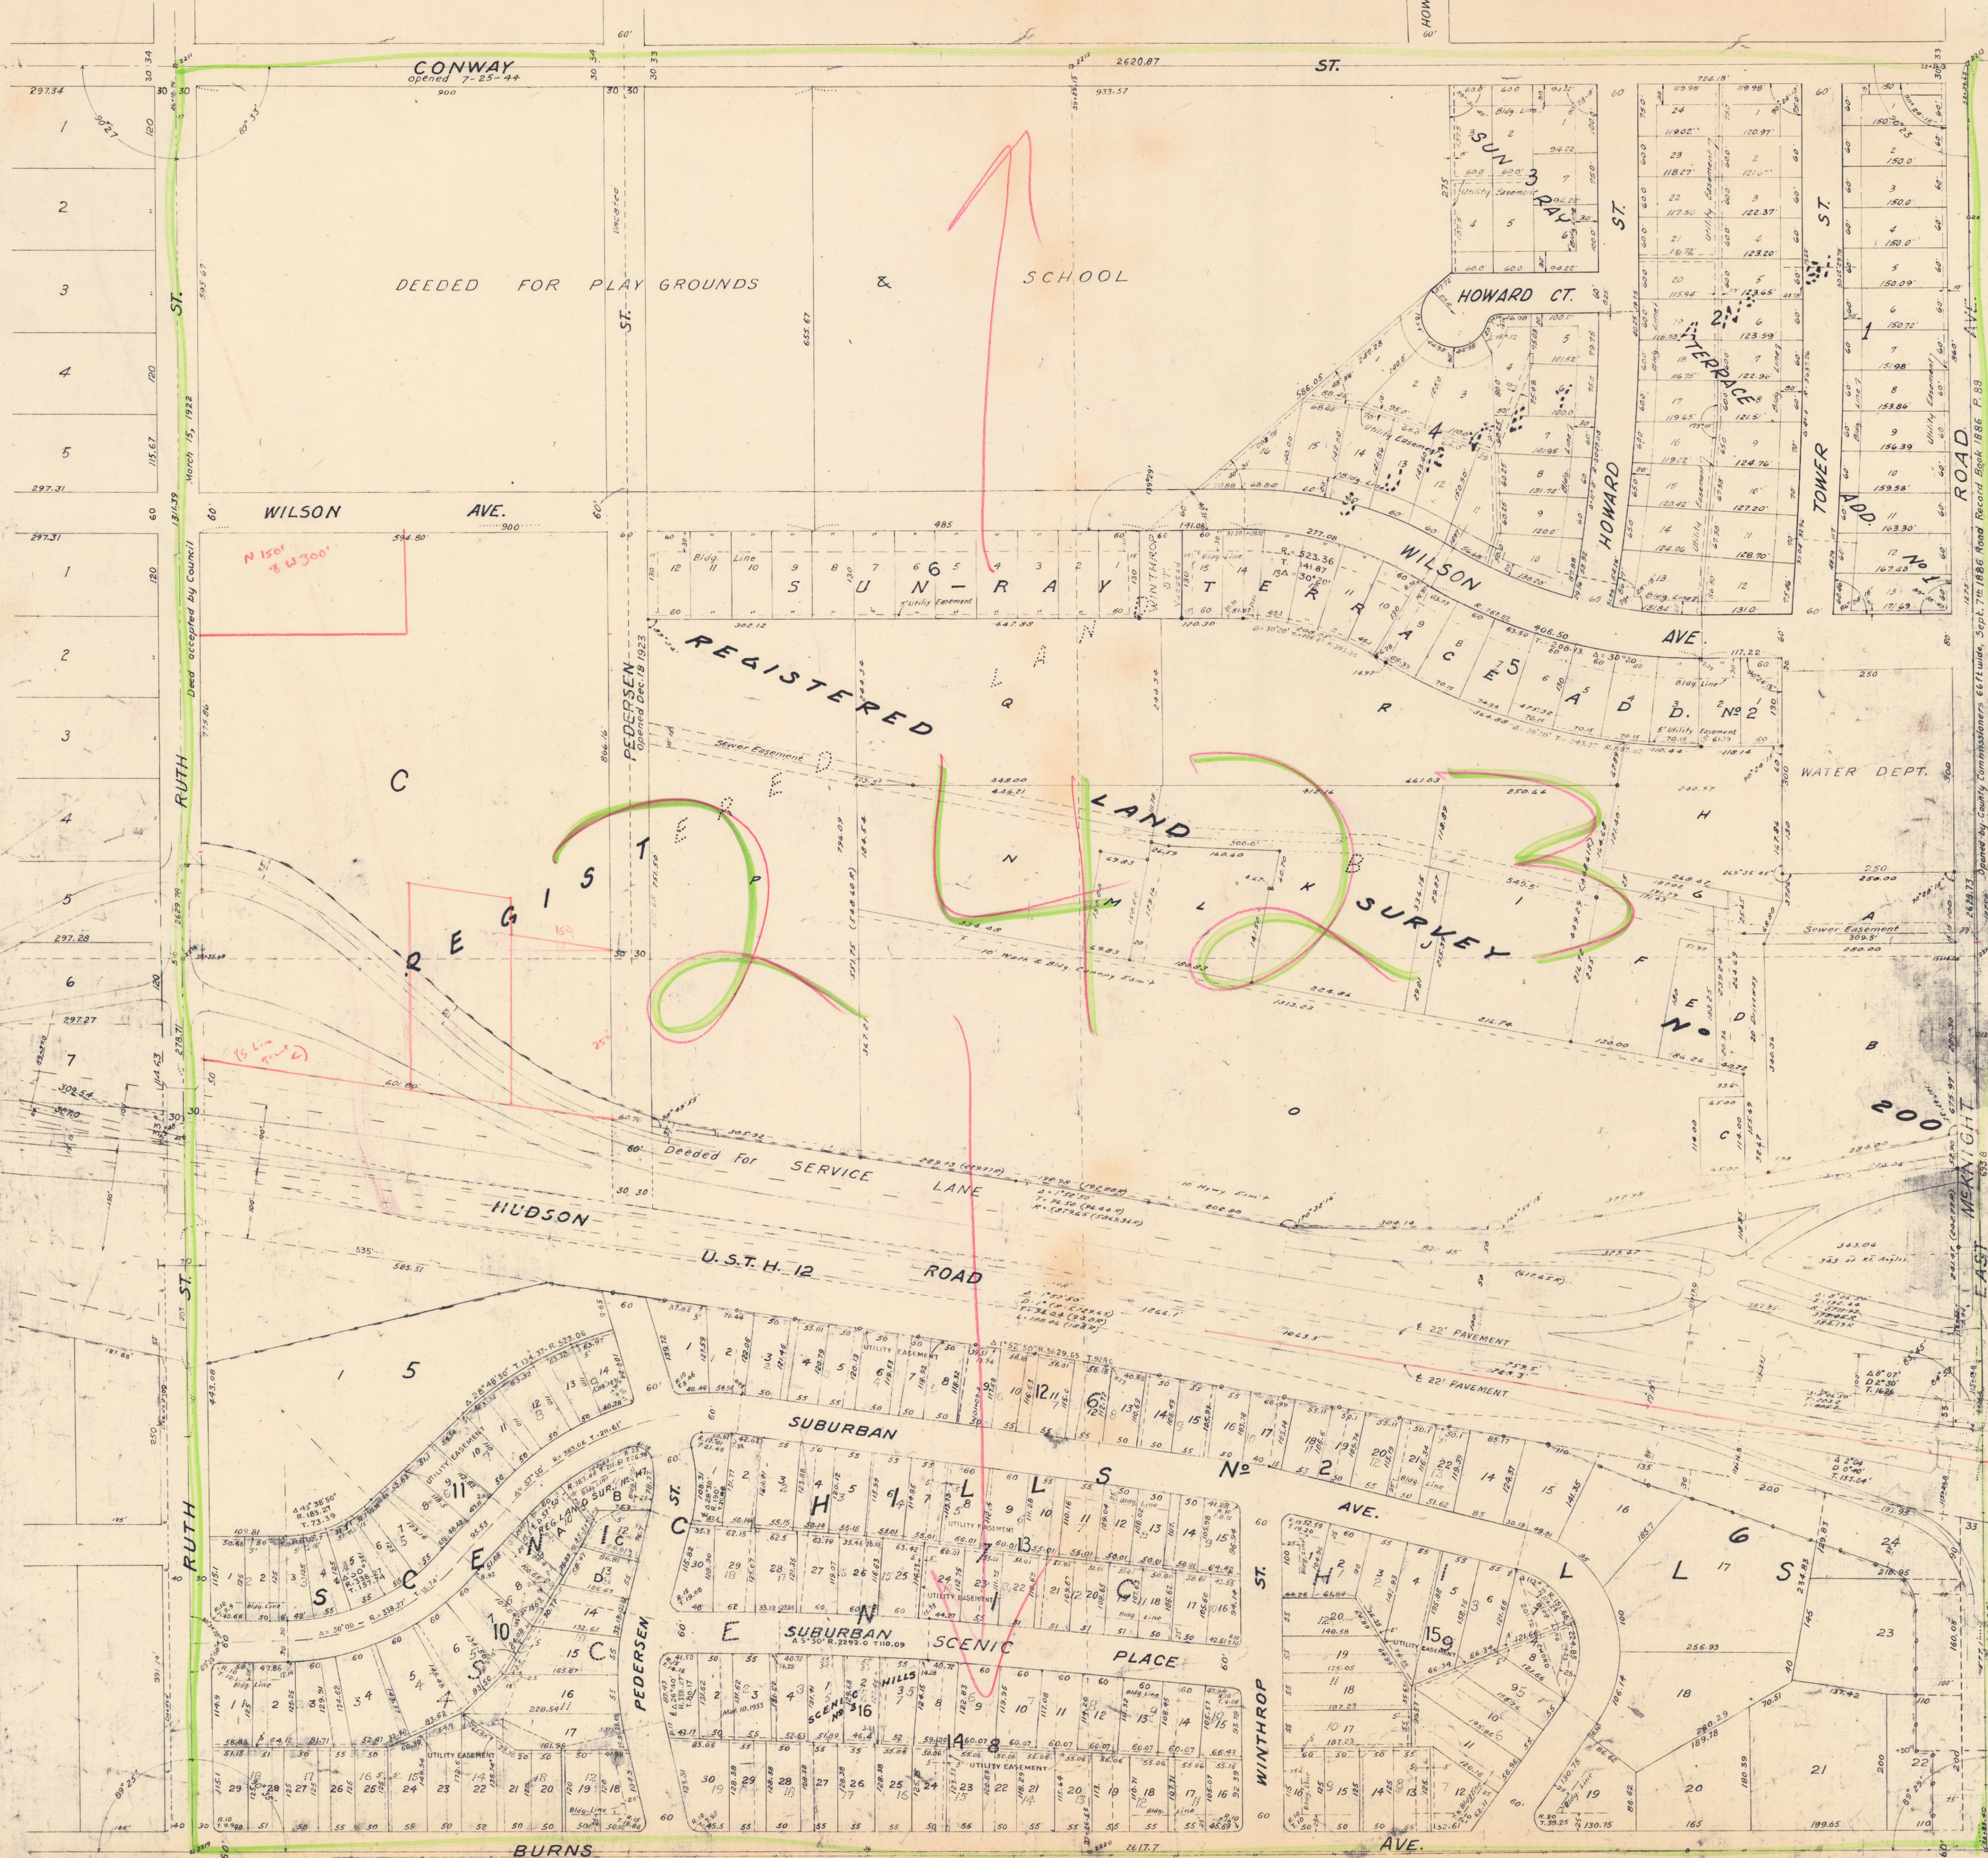

SE 1/4 35-29-22