


S.W. 1/4, Sec. 10-28-22.

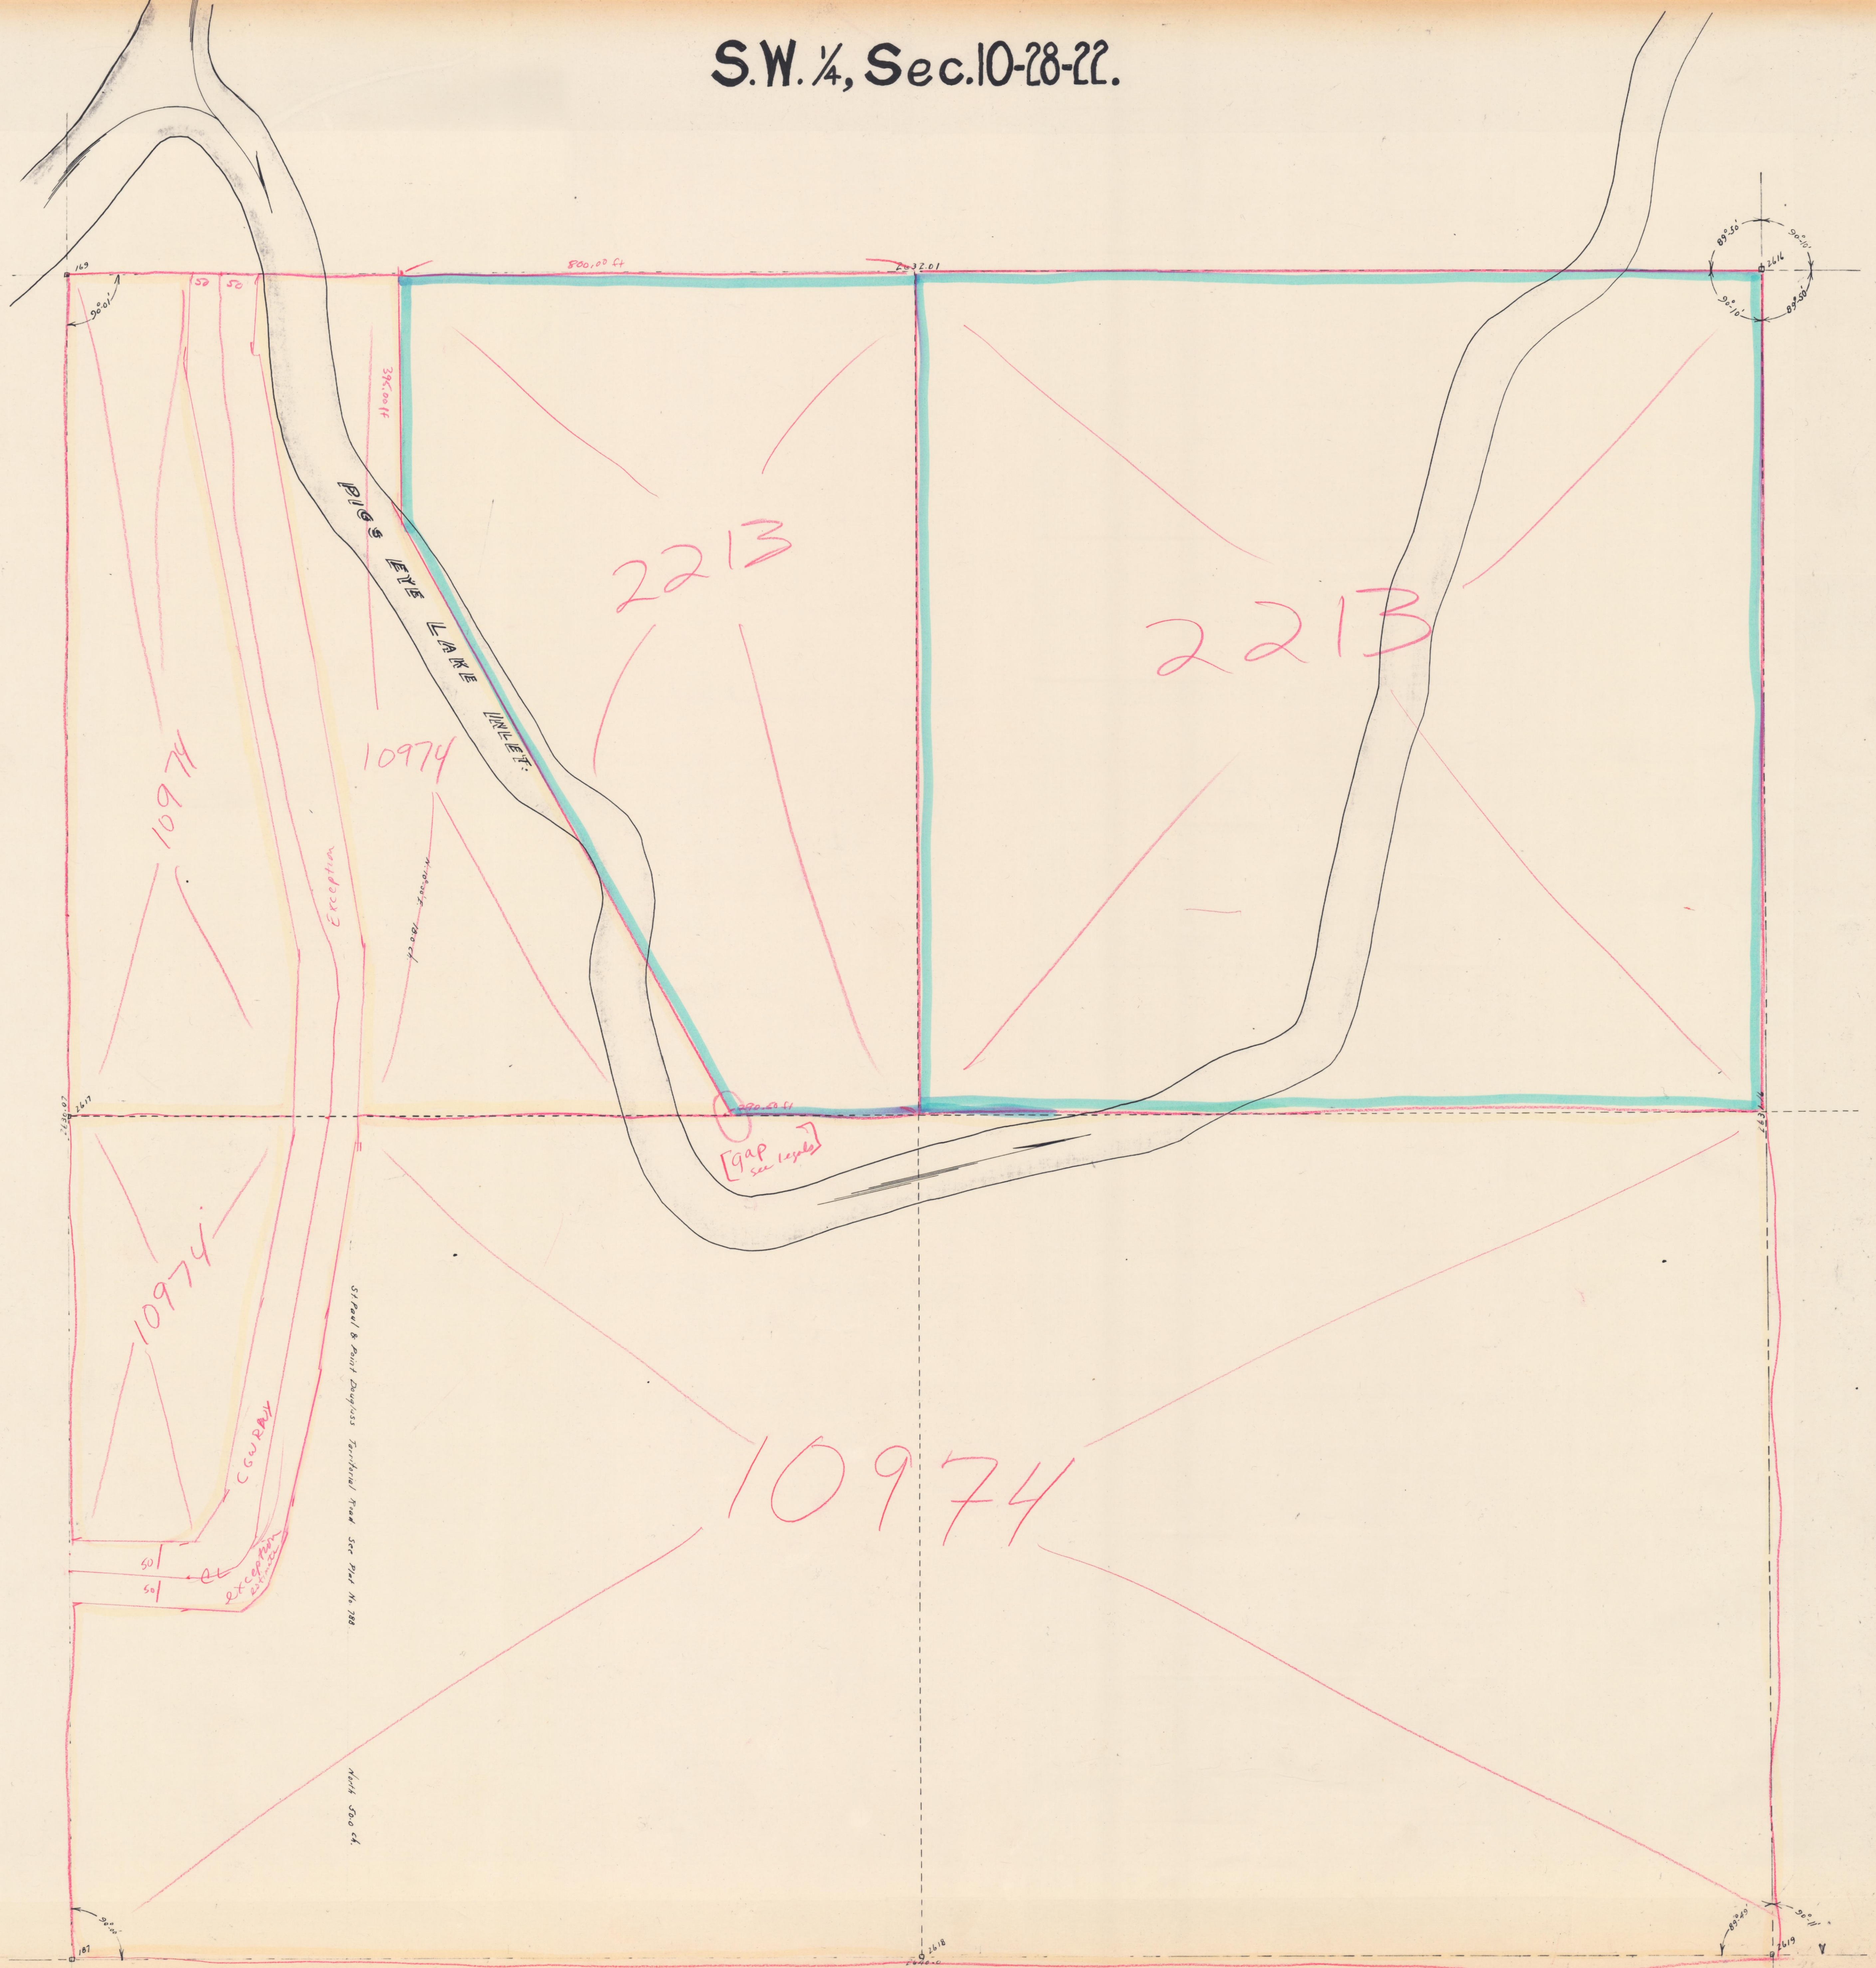

SW 1/4
10-28-22