


S. W. 1/4 Sec. 23—29—22

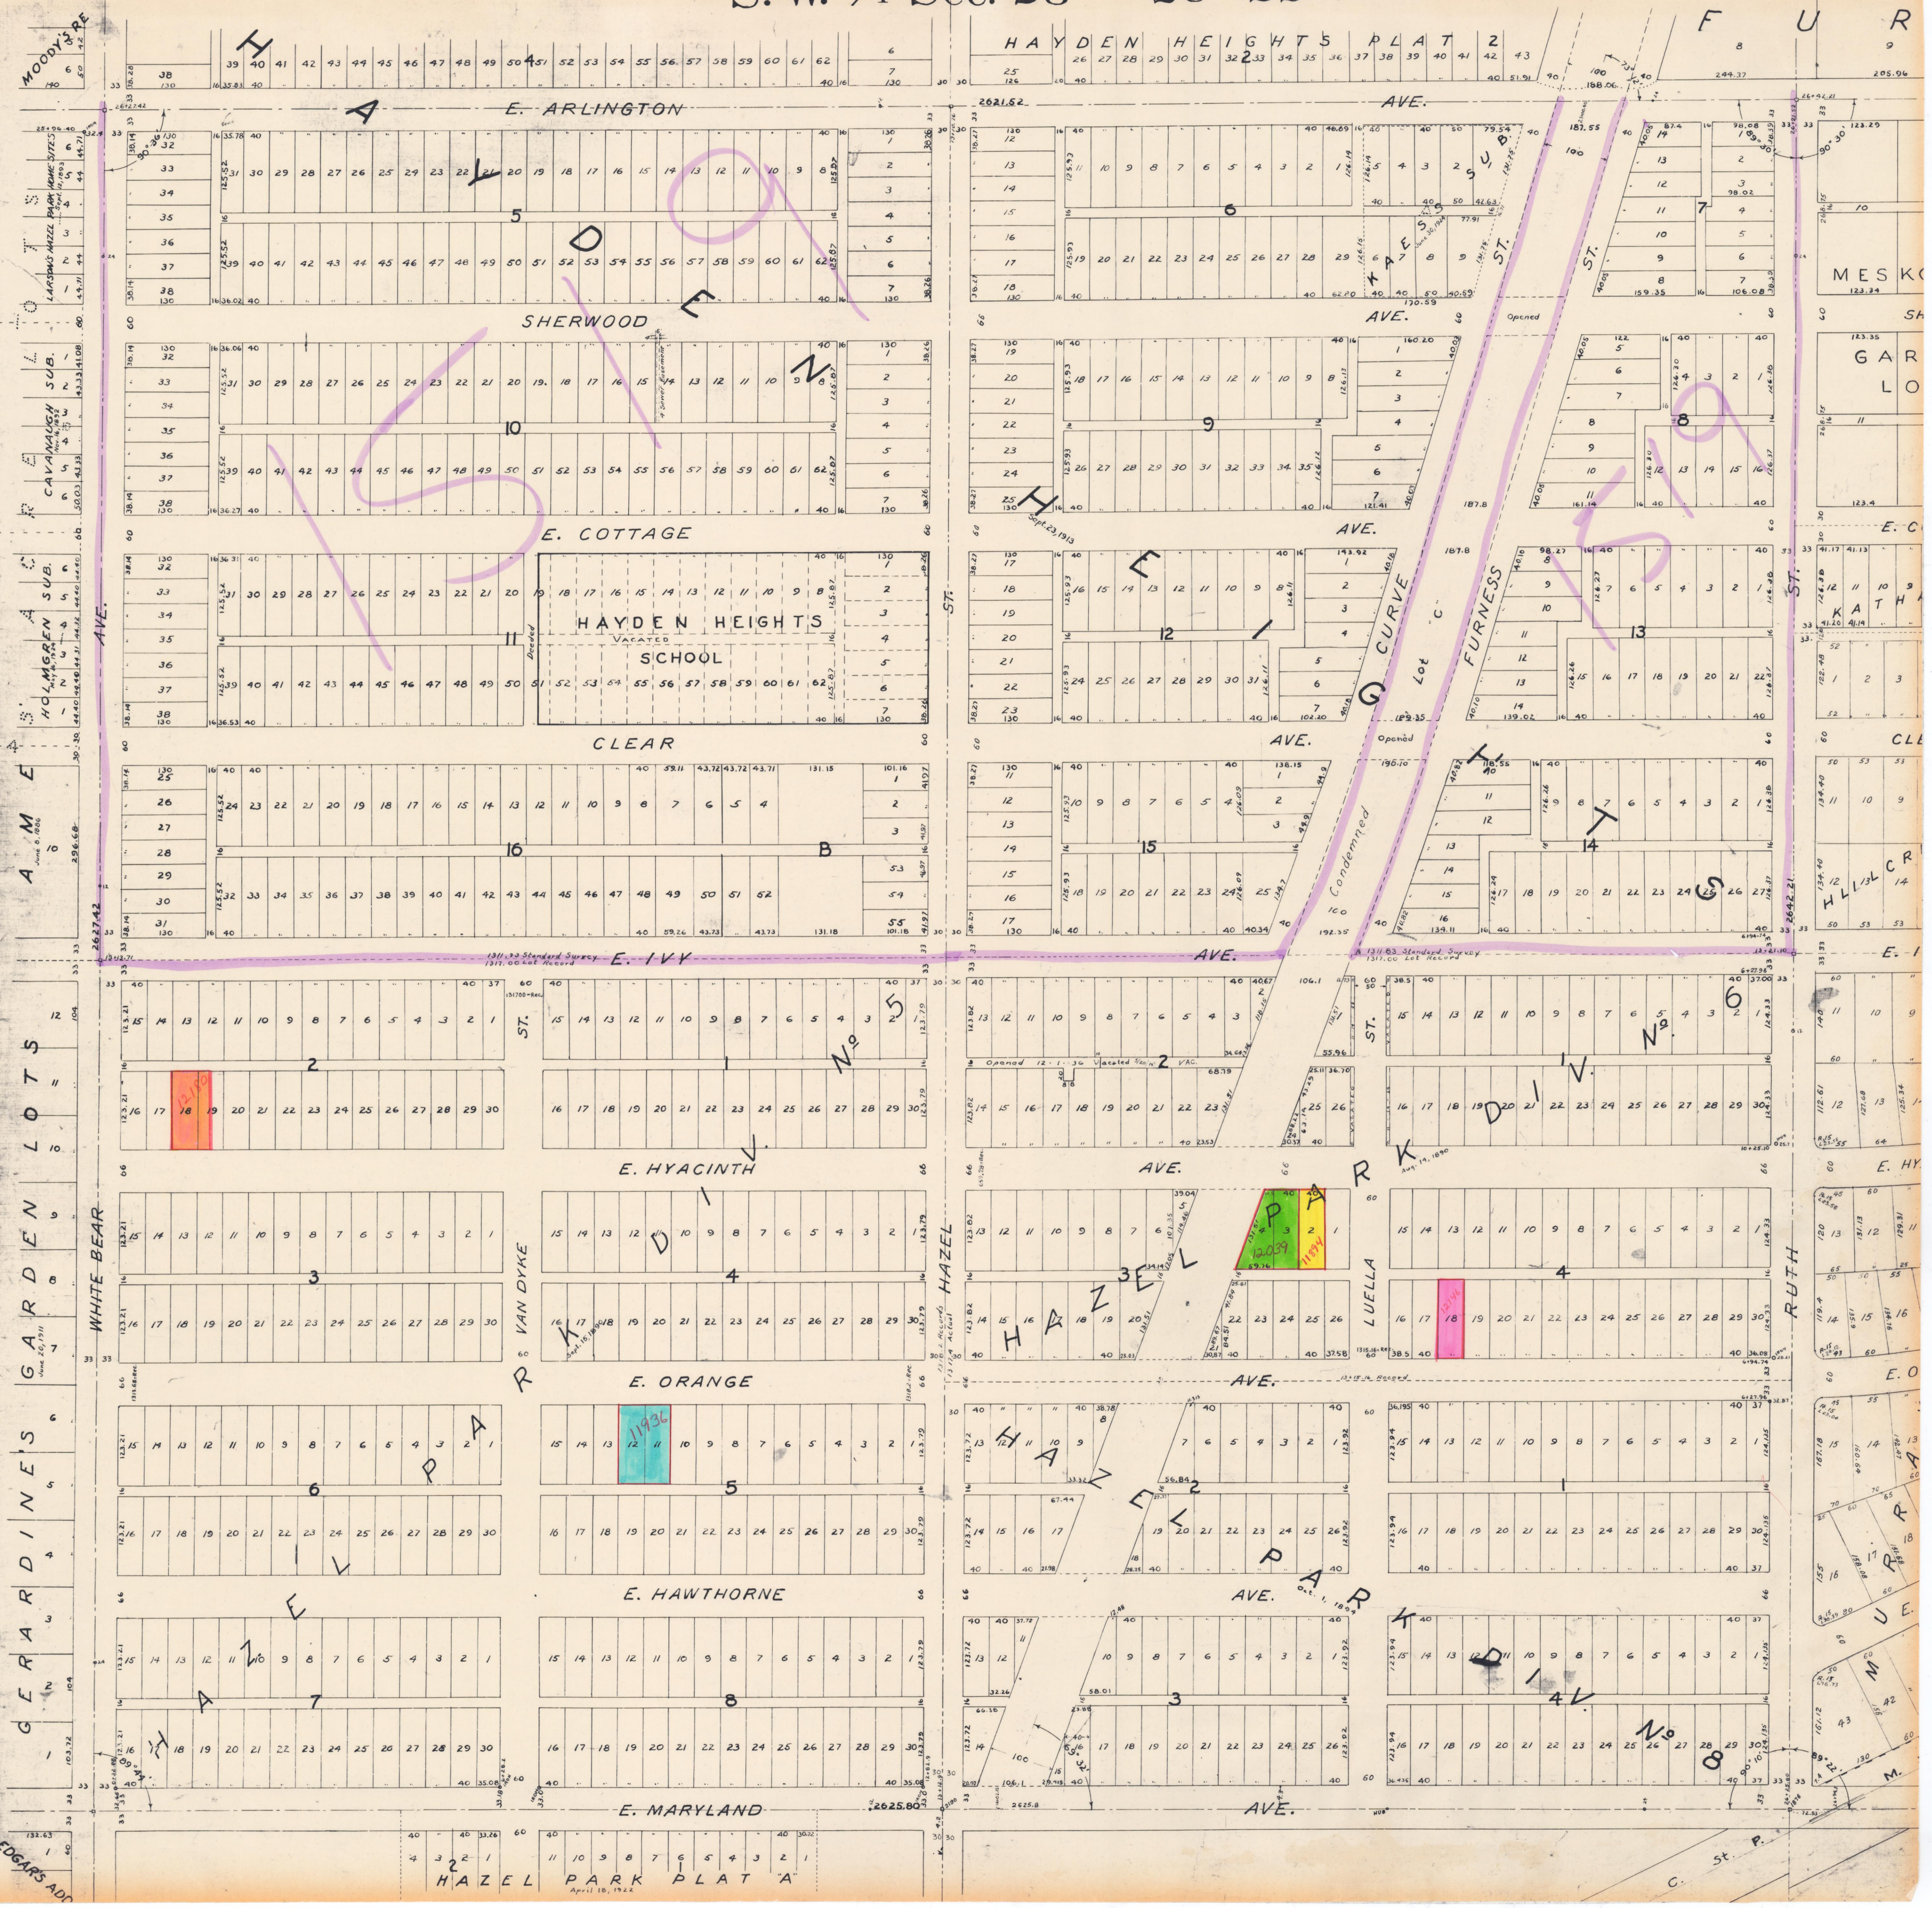

SW 1/4 23-29-22

EDGARS ADD

HAZEL PARK PLAT A
April 19, 1924