


S. W. 1/4 Sec. 26—29—23

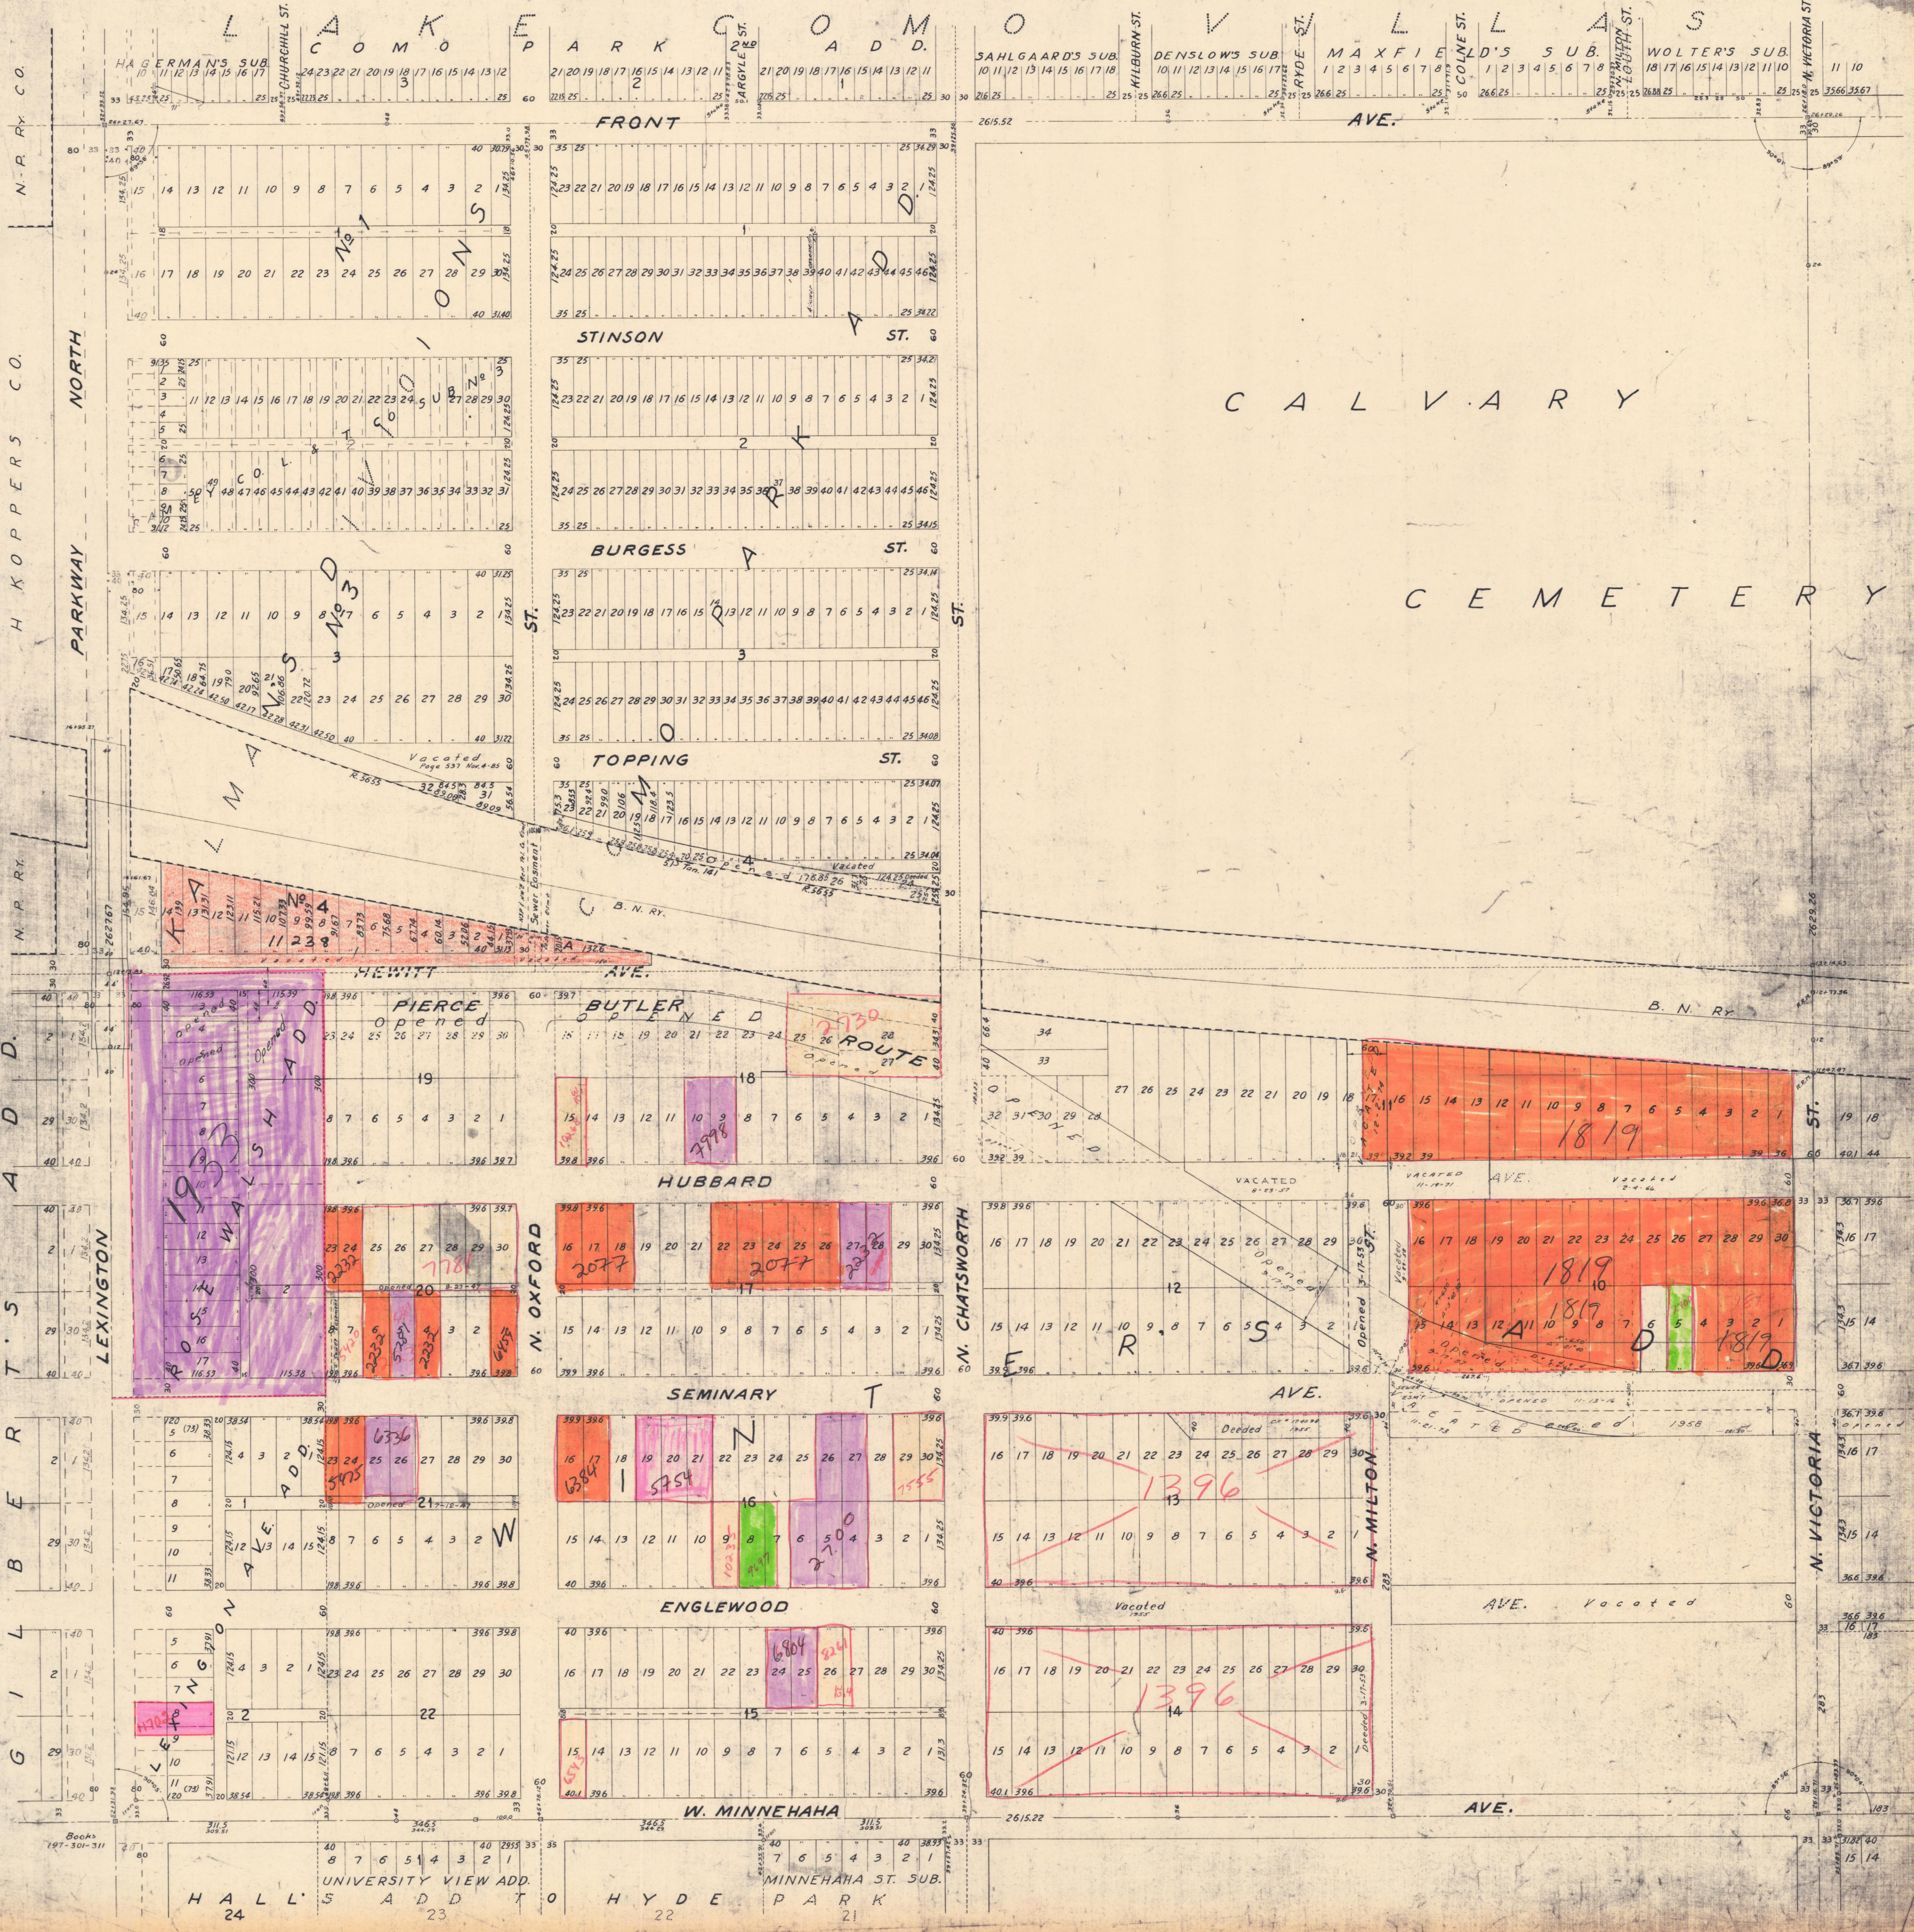

SW 1/4 26-29-23

DR 14

UNIVERSITY VIEW ADD. MINNEHAHA ST. SUB. HYDE PARK