


S.W. 1/4 SEC. 31-29-22

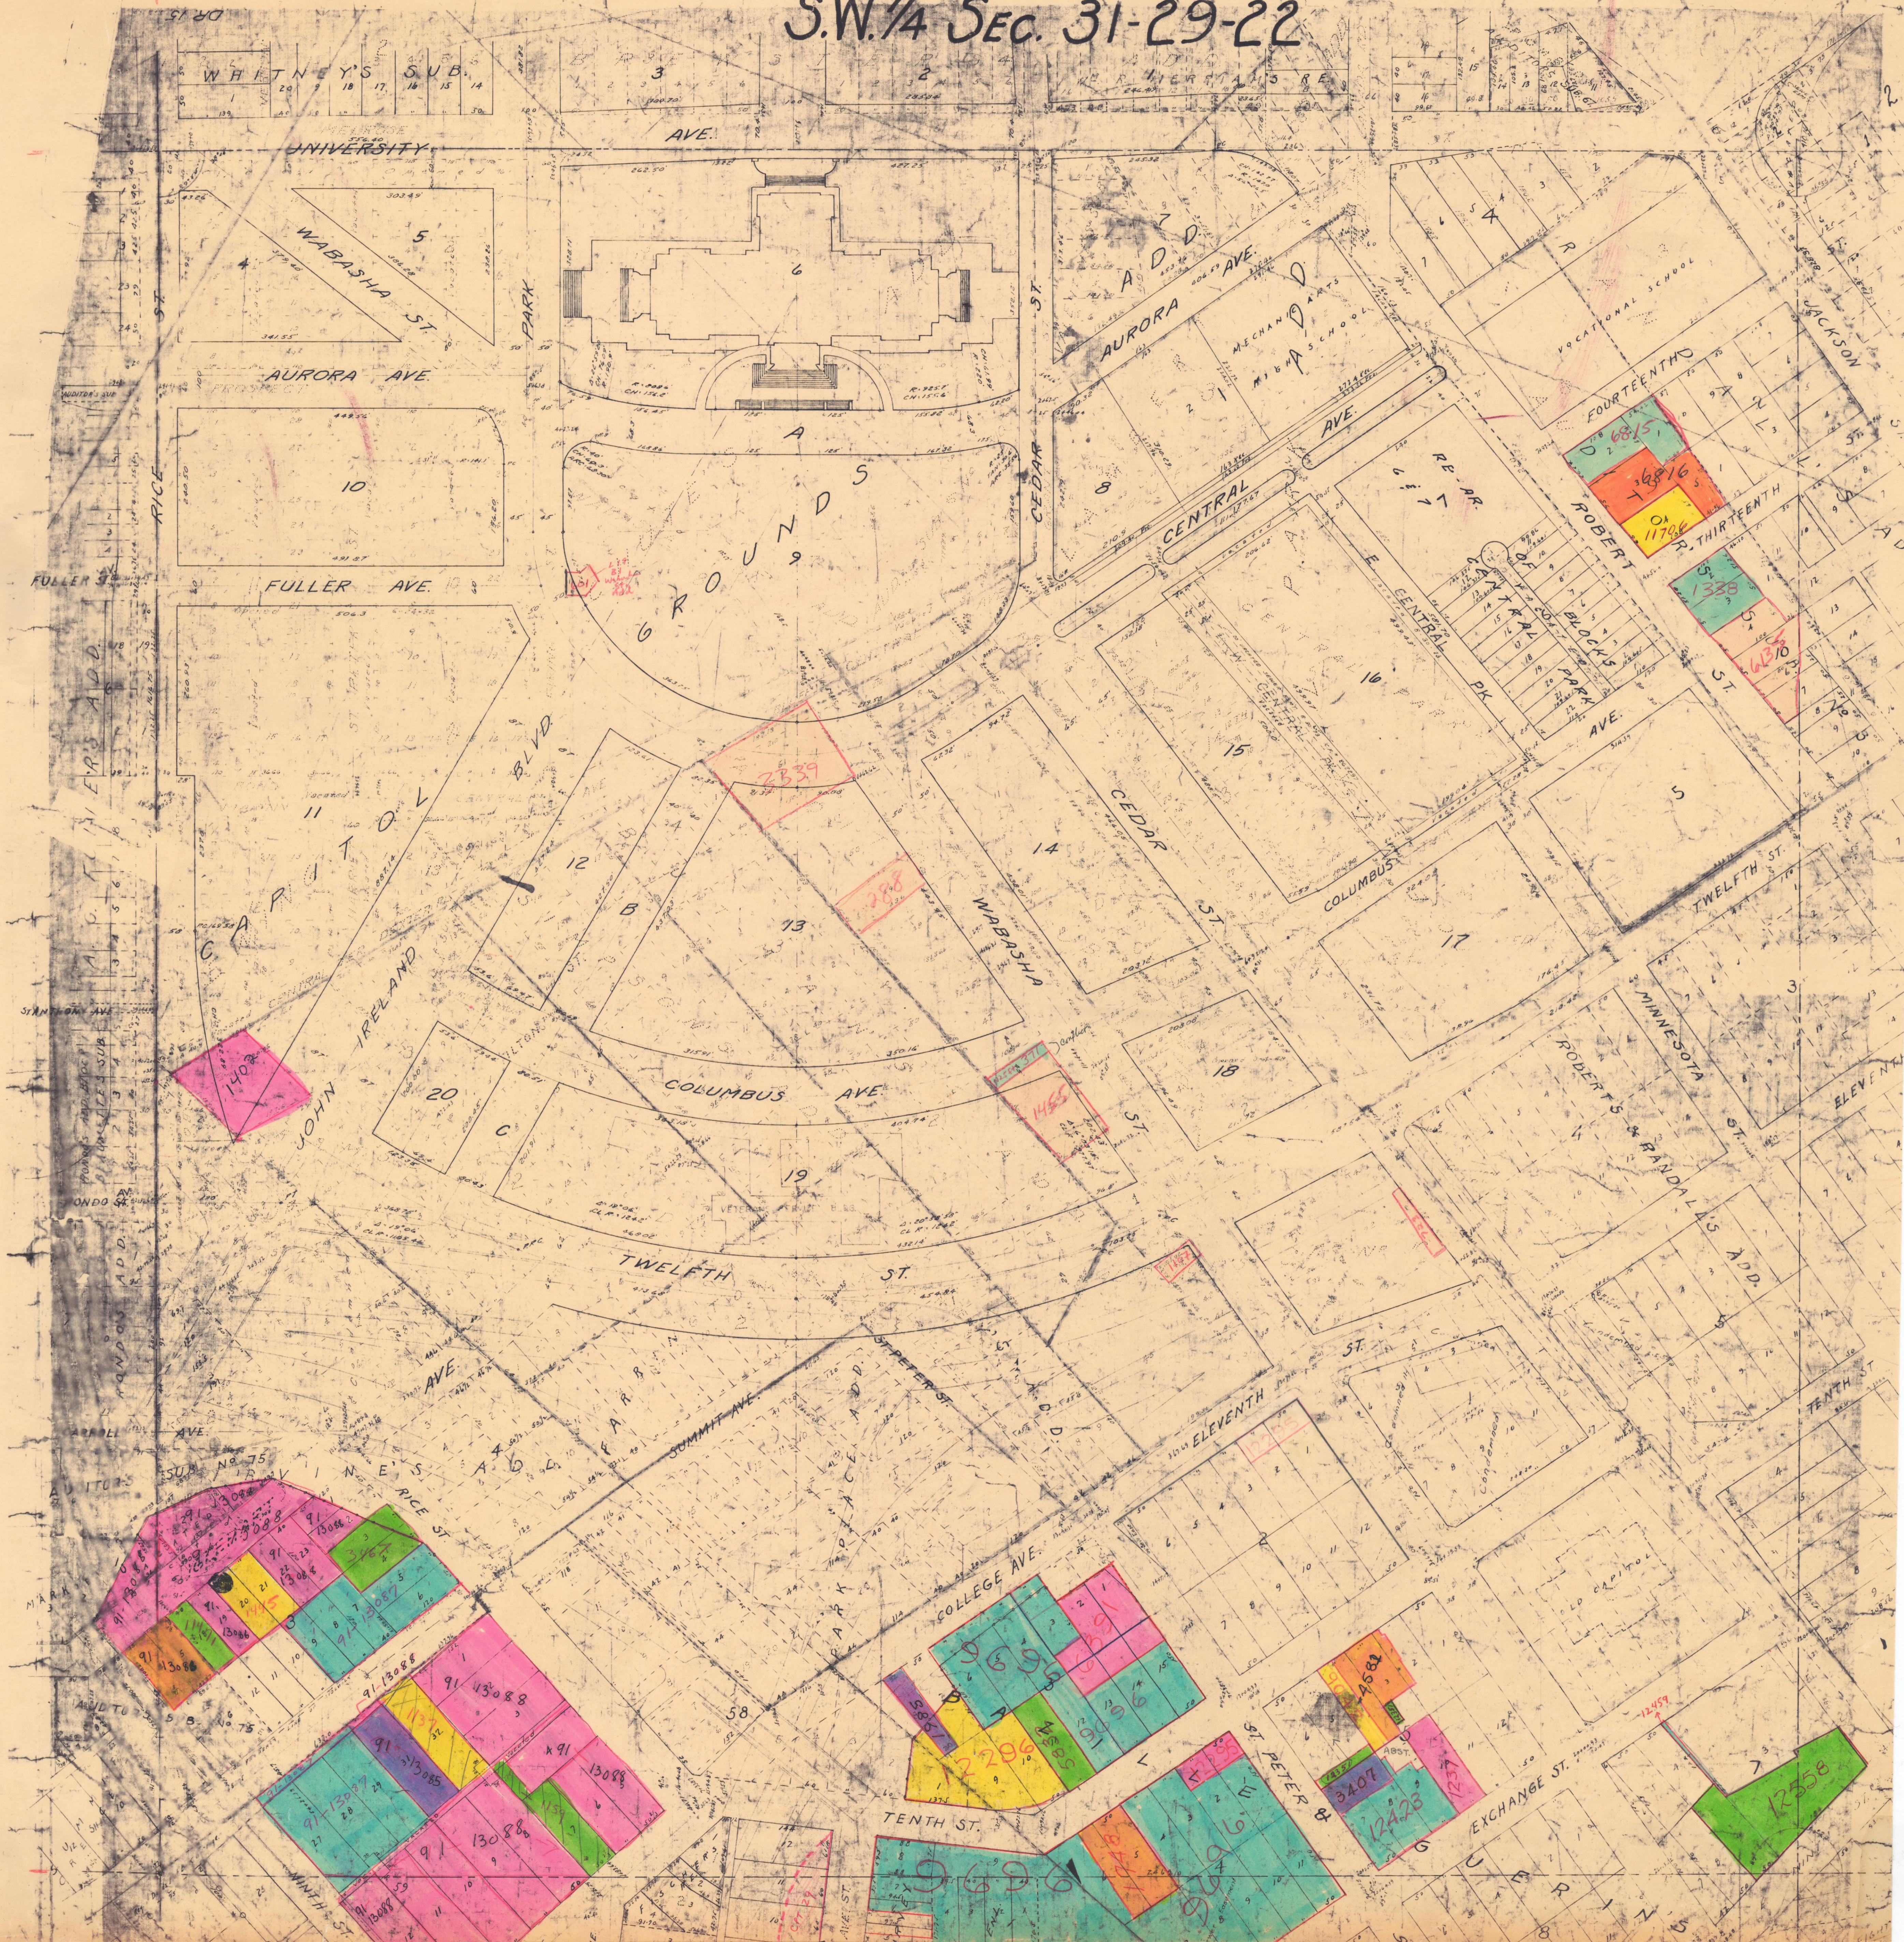

S.W. 1/4 31-29-22