PLAN OF THE WATER WORKS.

Ramsey County MINN.

Sheet No. 4.

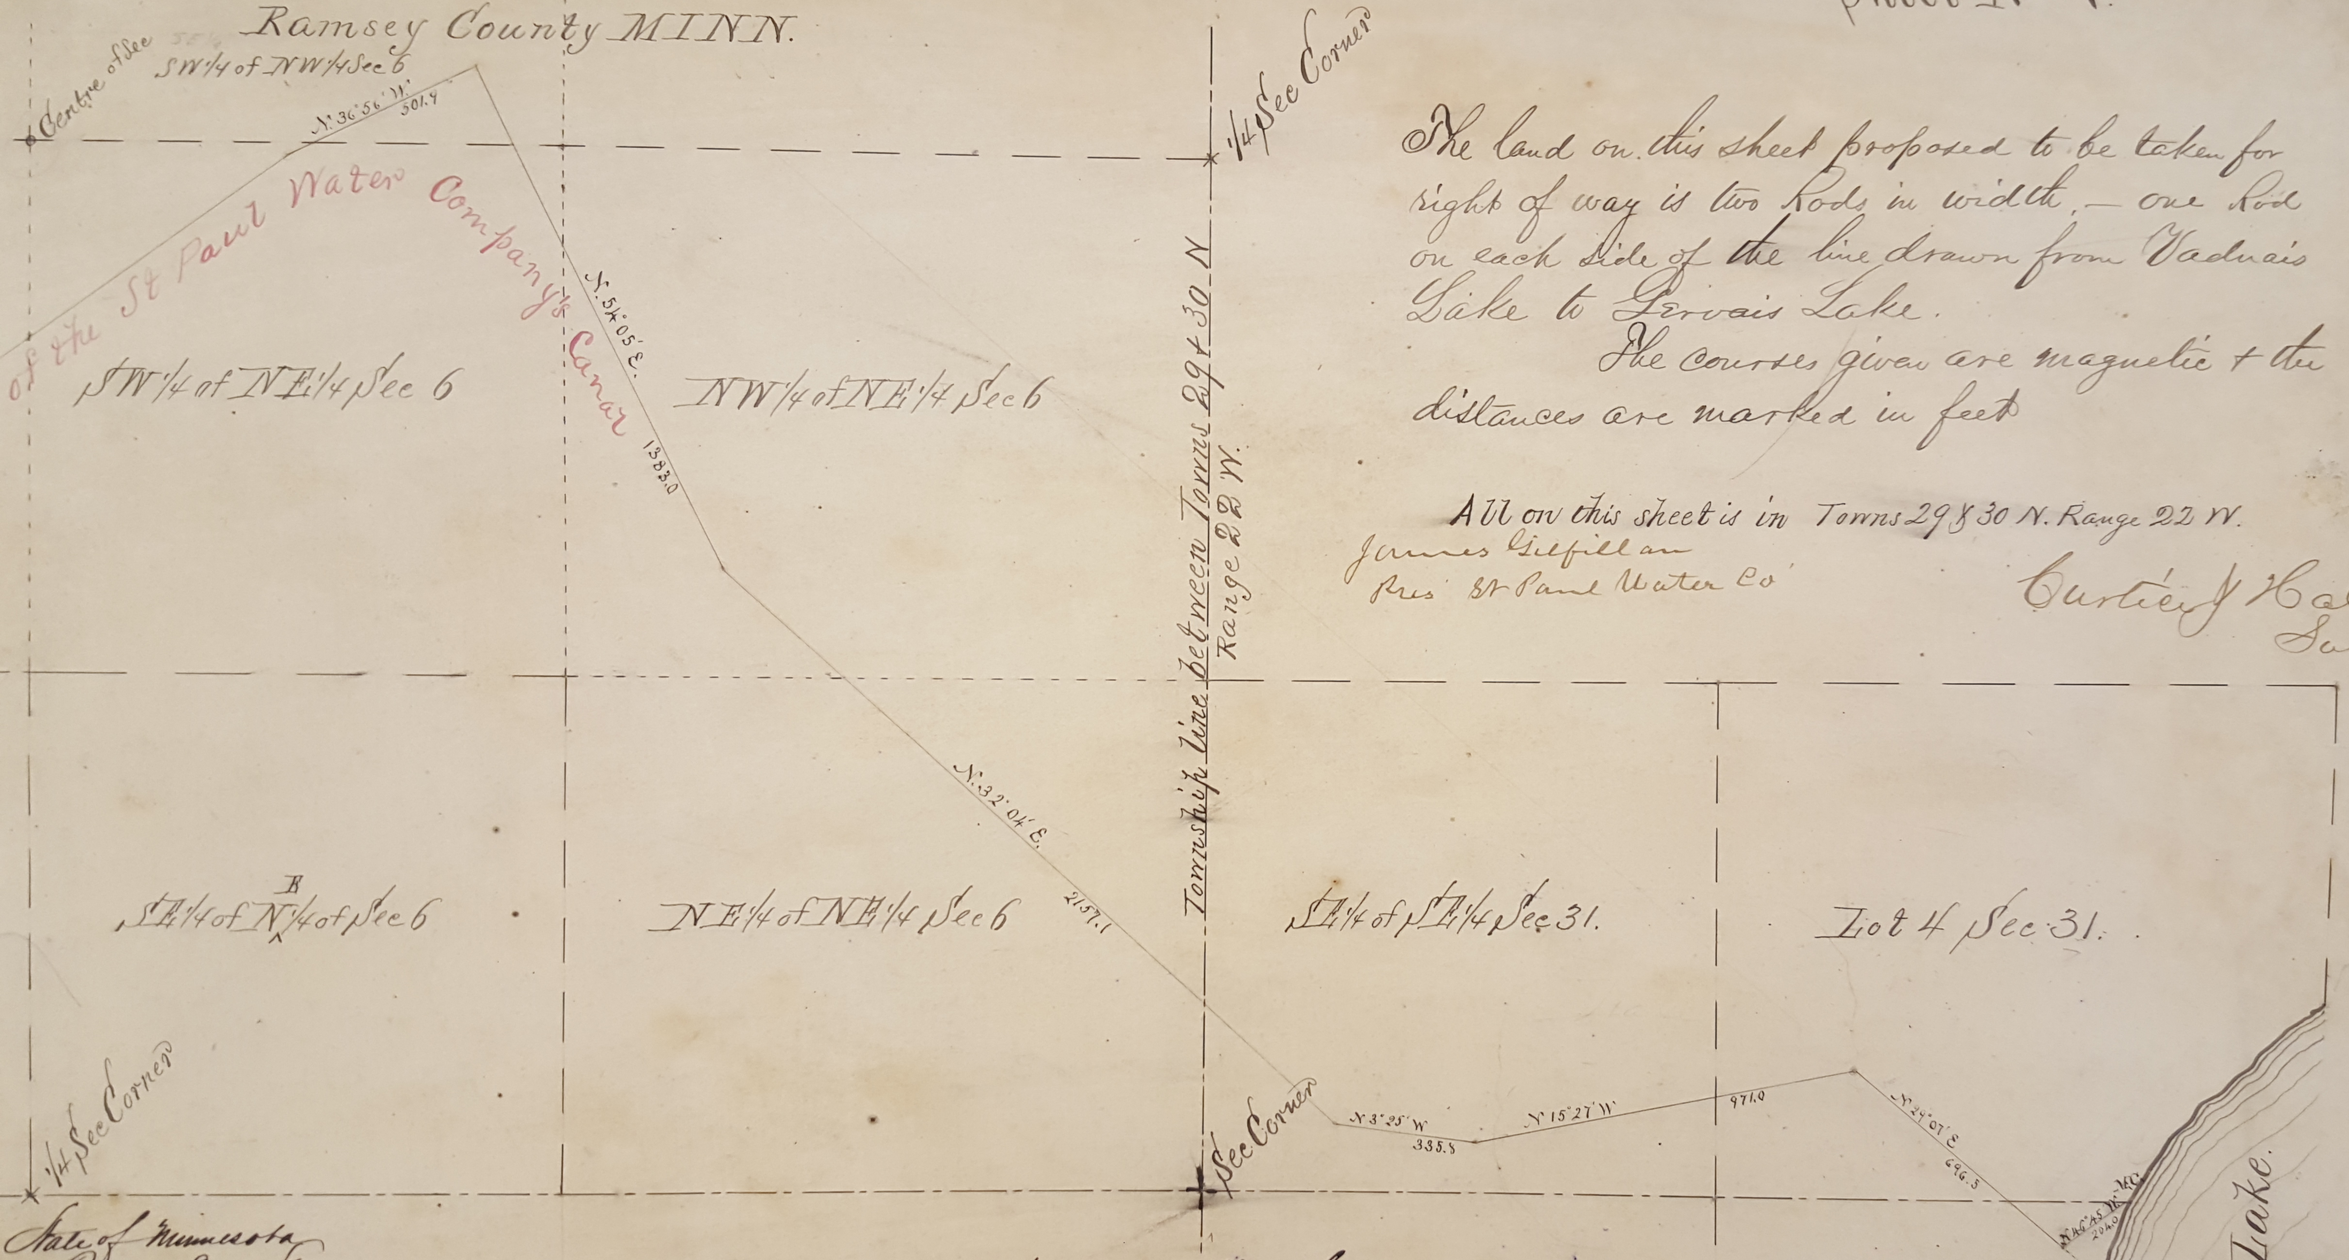

The land on this sheet proposed to be taken for right of way is two Rods in width, — one Rod on each side of the line drawn from Vadnais Lake to Gervais Lake.

The courses given are magnetic & the distances are marked in feet

All on this sheet is in Towns 29 & 30 N. Range 22 W.

James Gilfillan
Pres St Paul Water Co

Curtis J Halsted
Surveyor

State of Minnesota
Ramsey Co } ss.

On this 7th day of July 1869 before me came personally James Gilfillan to me known to be the President of the Saint Paul Water Company, and D L Curtice and J J Halsted to me known to be the surveyors who made the surveys for the line of the works of said Company and the line of said works heretofore located as such