

# CERTIFICATE OF LOCATION OF GOVERNMENT CORNER

CITY MON. NO. 6

OLD INDEX NO. 2683

1/4 Corner Corner of Section 22 Township 29 Range 23,      P.M.

STATE OF MINNESOTA, County of Ramsey

At the corner location shown on the sketch:

On 12-03-09 found a CIM, under cover 1.40'  
date


Below Concrete Pavement (set SE EDM TIES)

- left monument as found       lowered monument       removed monument (explain)

On 12-03-09 placed a New Ties  
date

CREW DN, KL

SKETCH OF REFERENCE TIES

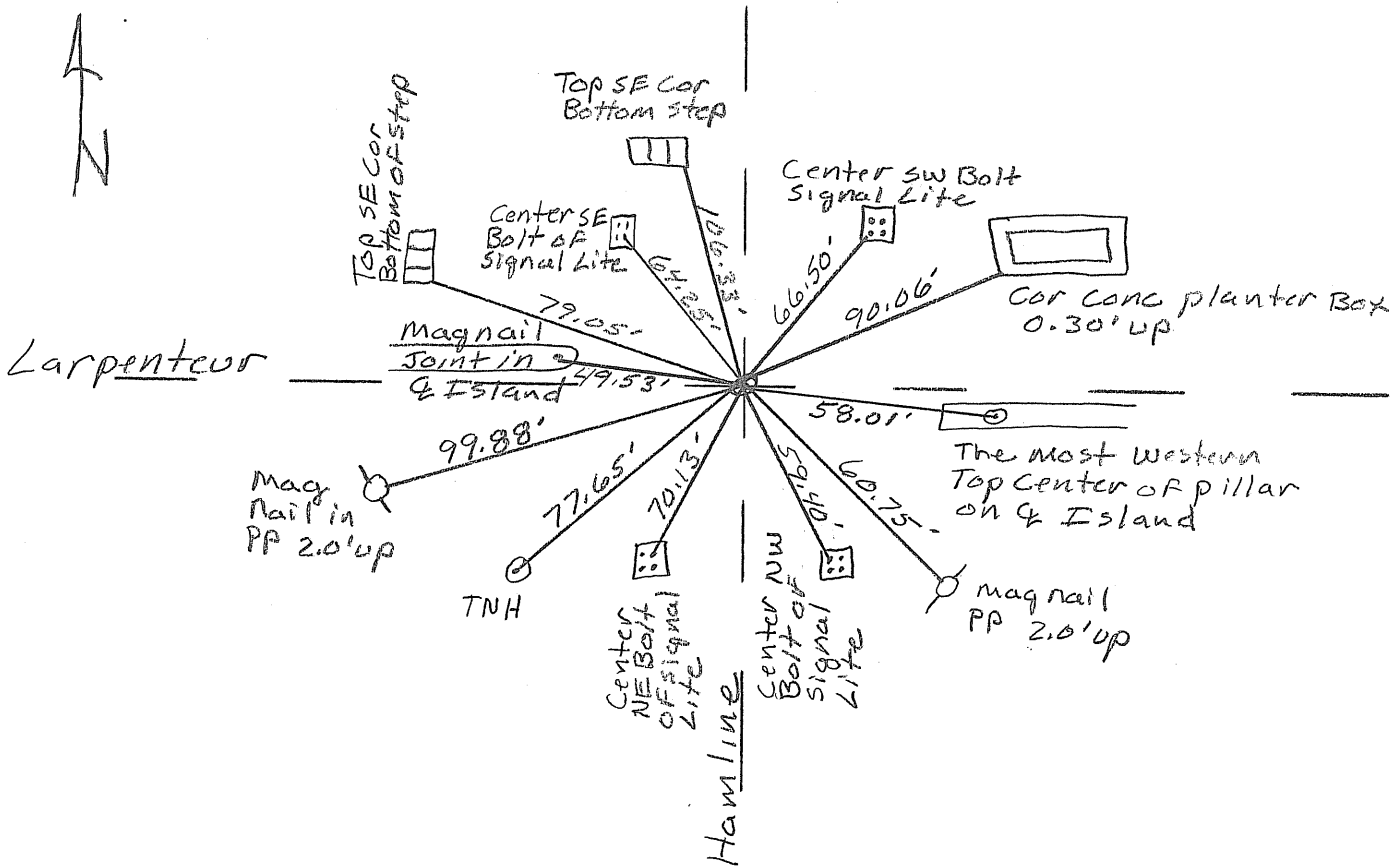

Statement of evidence relative to this corner is available from the St. Paul Public Works Dept., Survey Division

I hereby certify that this document and the data contained herein was prepared by me or under my direct supervision.

SIGNATURE

*[Handwritten Signature]*

Feb 3, 2010

DATE

Registration No. 44880

- Land Surveyor       County Surveyor  
 Professional Engineer  
 Chief Surveyor, City of St. Paul

Office of The County Recorder, County of Ramsey

I hereby certify that this document was filed in the county

Recorders office at \_\_\_\_\_ M. on the \_\_\_\_\_ day of \_\_\_\_\_

County Recorder \_\_\_\_\_

By \_\_\_\_\_, Deputy

DOCUMENT NUMBER \_\_\_\_\_