

CERTIFICATE OF LOCATION OF GOVERNMENT CORNER

CITY MON. NO. 7

OLD INDEX NO. 1044

Northwest Corner of Section 23 Township 29 Range 23, 4th P.M.

STATE OF MINNESOTA, County of Ramsey

At the corner location shown on the sketch:

On 12-03-09 found a CIM, under cover 1.40'


below concrete Pavement (SET SE EDM TIES)

- left monument as found lowered monument removed monument (explain)

On 12-03-09 placed a New Ties

CREW DN, KL

SKETCH OF REFERENCE TIES

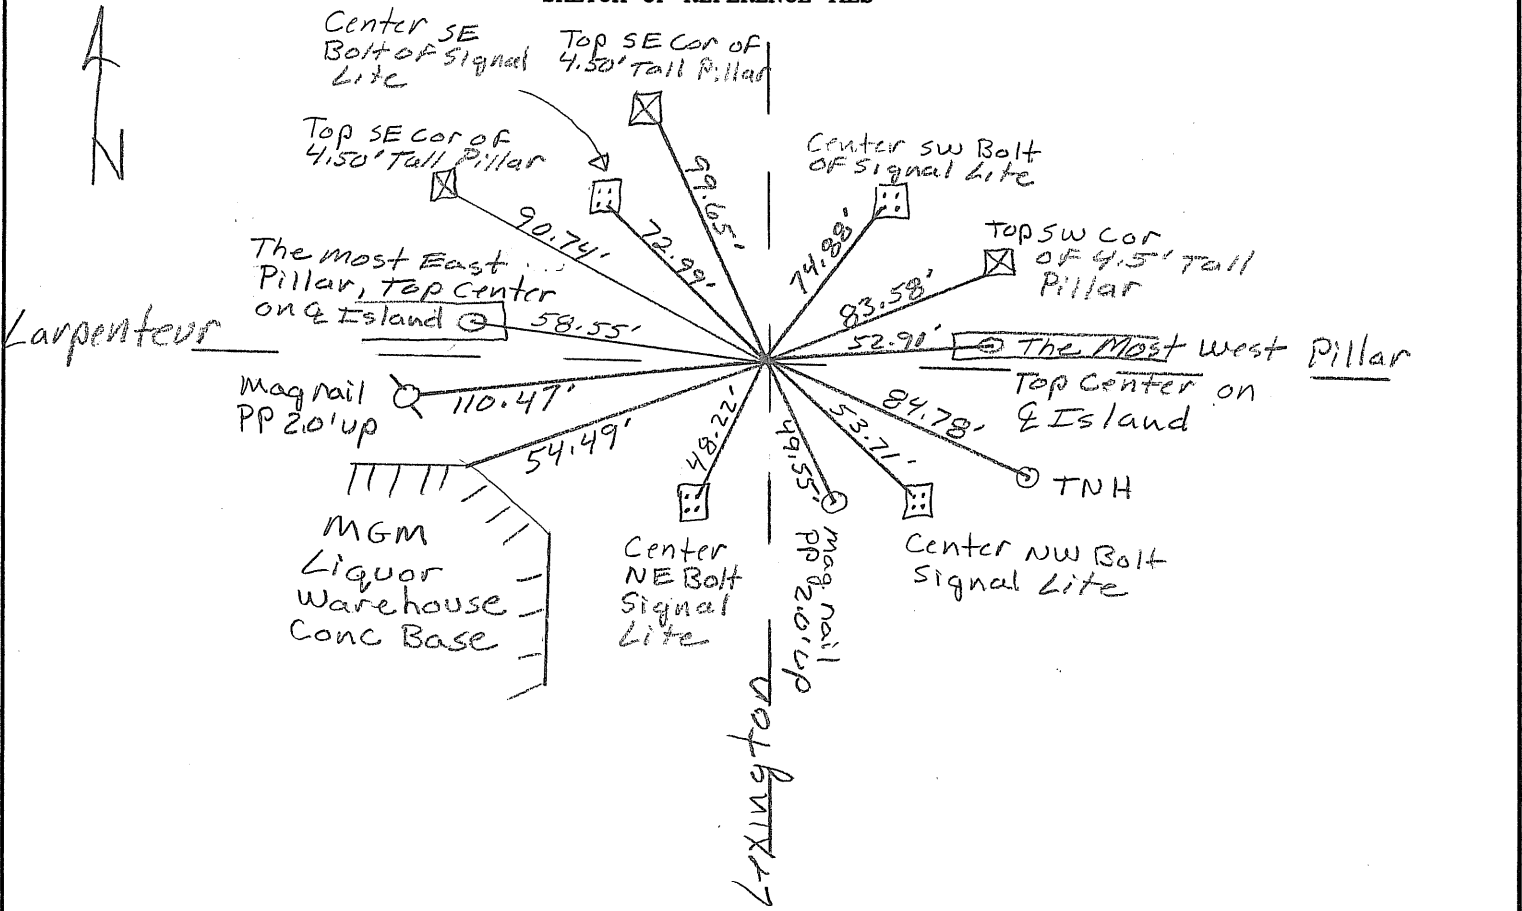

Statement of evidence relative to this corner is available from the St. Paul Public Works Dept., Survey Division

I hereby certify that this document and the data contained herein was prepared by me or under my direct supervision.

[Signature] Feb 3, 2010
SIGNATURE DATE

Registration No. 44880

- Land Surveyor County Surveyor
 Professional Engineer
 Chief Surveyor, City of St. Paul

Office of The County Recorder, County of Ramsey

I hereby certify that this document was filed in the county
Recorders office at _____ M. on the _____ day of _____

County Recorder _____

By _____, Deputy

DOCUMENT NUMBER _____