

# CERTIFICATE OF LOCATION OF GOVERNMENT CORNER

CITY MON. NO. 10

OLD INDEX NO. 14

N. 1/4 Corner of Section 24 Township 29 Range 23, \_\_\_ P.M.


STATE OF MINNESOTA, County of Ramsey  
At the corner location shown on the sketch:

On 12-07-09 found a CIM @ Grade  
date

- left monument as found       lowered monument       removed monument (explain)

On 12-07-09 placed a (New ties, set SE EDM TIES)  
date CREW DN, KL

SKETCH OF REFERENCE TIES

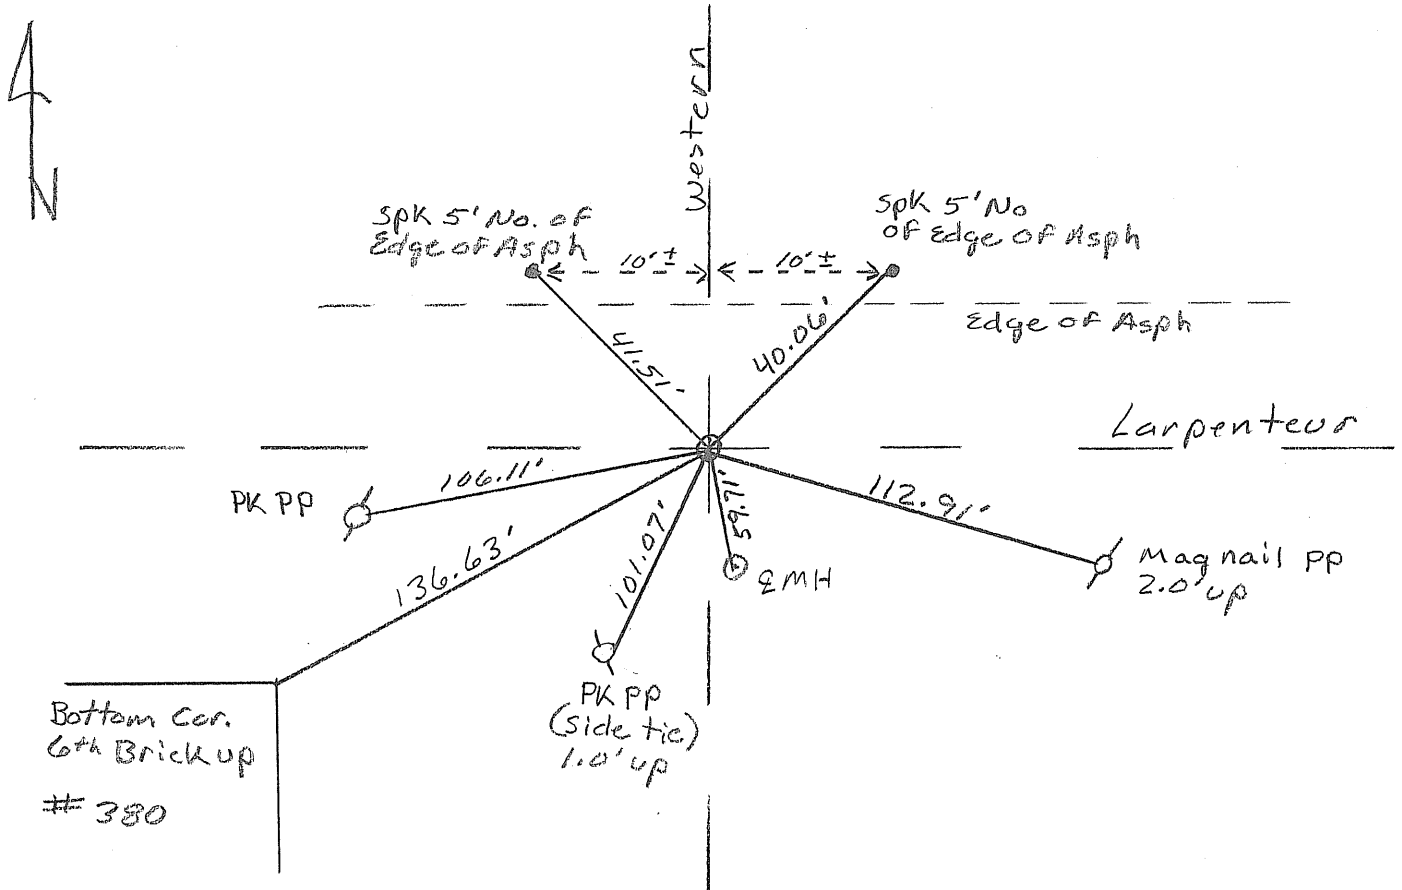

Statement of evidence relative to this corner is available from the St. Paul Public Works Dept., Survey Division

I hereby certify that this document and the data contained herein was prepared by me or under my direct supervision.

[Signature] Feb 3, 2010  
SIGNATURE DATE

- Registration No. 44880
- Land Surveyor       County Surveyor  
 Professional Engineer  
 Chief Surveyor, City of St. Paul

Office of The County Recorder, County of Ramsey

I hereby certify that this document was filed in the county  
Recorders office at \_\_\_\_\_ M. on the \_\_\_\_\_ day of \_\_\_\_\_

County Recorder \_\_\_\_\_

By \_\_\_\_\_, Deputy

DOCUMENT NUMBER \_\_\_\_\_