

CERTIFICATE OF LOCATION OF GOVERNMENT CORNER

CITY MON. NO. 12

OLD INDEX NO. eu

1/4 Corner of Section 20 Township 29 Range 22, P.M.

STATE OF MINNESOTA, County of Ramsey


At the corner location shown on the sketch:

On 12-18-09 found a CIM @ Grade
date

- left monument as found lowered monument removed monument (explain)

On 12-18-09 placed a New Ties (set 5E EDM Ties)
date CREW DN, KL

SKETCH OF REFERENCE TIES

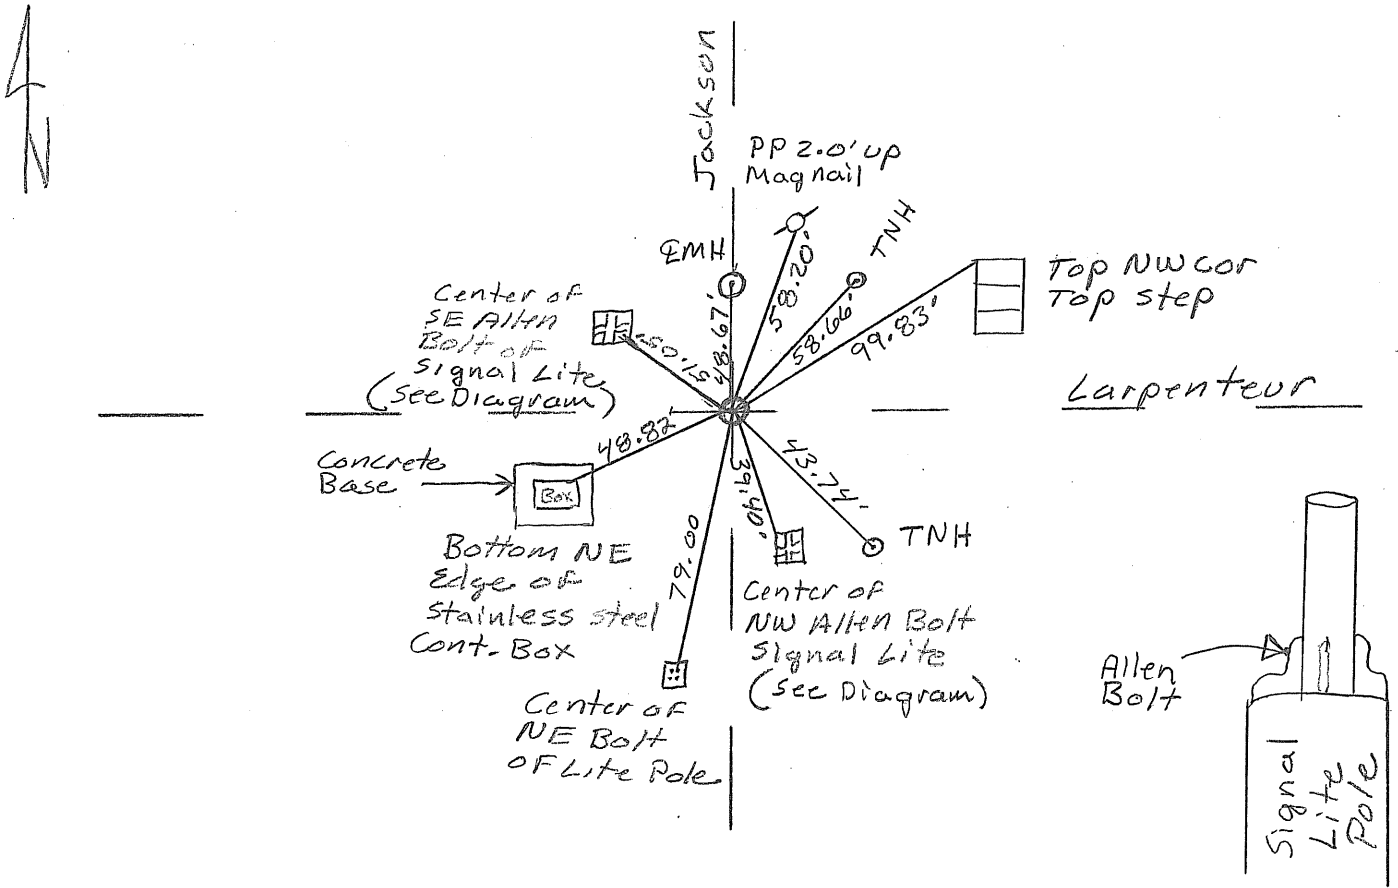

Statement of evidence relative to this corner is available from the St. Paul Public Works Dept., Survey Division

I hereby certify that this document and the data contained herein was prepared by me or under my direct supervision.

[Signature] 2010
JAN 7, 2010
SIGNATURE DATE

Registration No. 44880

- Land Surveyor County Surveyor
 Professional Engineer
 Chief Surveyor, City of St. Paul

Office of The County Recorder, County of Ramsey

I hereby certify that this document was filed in the county
 Recorders office at M. on the day of

County Recorder
 By , Deputy

DOCUMENT NUMBER