

# CERTIFICATE OF LOCATION OF GOVERNMENT CORNER

CITY MON. NO. 13

OLD INDEX NO. 10.61

NW Corner of Section 20 Township 29 Range 22,      P.M.

STATE OF MINNESOTA, County of Ramsey


At the corner location shown on the sketch:

On 12-16-09 found a CIM e Grade  
date

- left monument as found     
  lowered monument     
  removed monument (explain)

On 12-16-09 placed a New Ties (set SE EDMTIES)  
date CREW DN, KL

SKETCH OF REFERENCE TIES

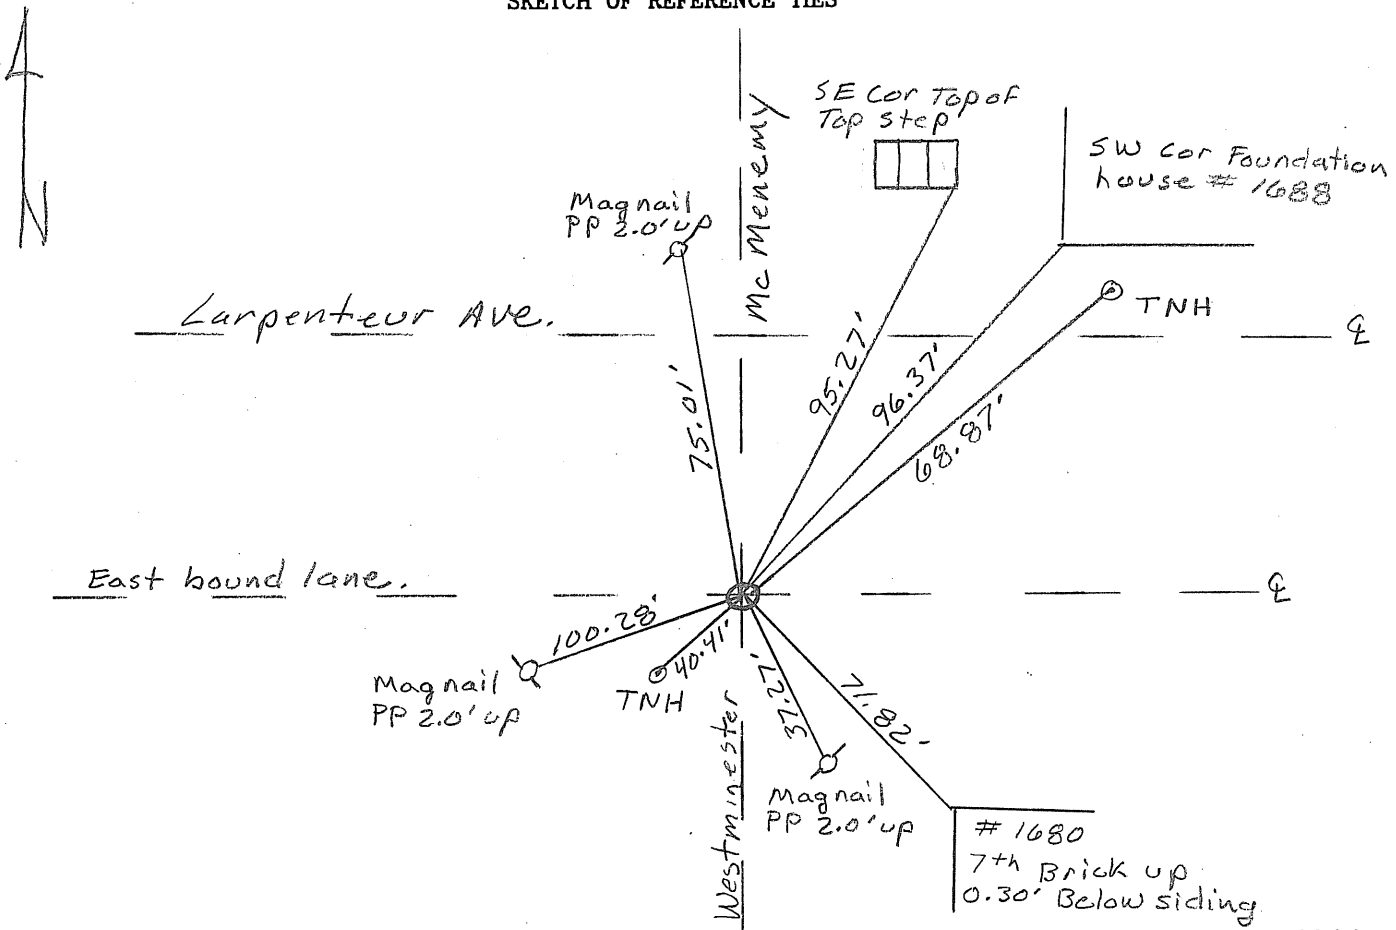

Statement of evidence relative to this corner is available from the St. Paul Public Works Dept., Survey Division

I hereby certify that this document and the data contained herein was prepared by me or under my direct supervision.

  
 SIGNATURE \_\_\_\_\_ DATE 2010 Jan 7, 2009

- Registration No. 44880
- Land Surveyor       County Surveyor  
 Professional Engineer  
 Chief Surveyor, City of St. Paul

Office of The County Recorder, County of Ramsey

I hereby certify that this document was filed in the county  
 Recorders office at \_\_\_\_\_ M. on the \_\_\_\_\_ day of \_\_\_\_\_

County Recorder \_\_\_\_\_

By \_\_\_\_\_, Deputy

DOCUMENT NUMBER \_\_\_\_\_