

CERTIFICATE OF LOCATION OF GOVERNMENT CORNER

CITY MON. NO. 27

OLD INDEX NO. 1

Center 1/4 Corner of Section 22 Township 29 Range 23, 4th P.M.

STATE OF MINNESOTA, County of Ramsey


At the corner location shown on the sketch:

On Nov 9, 2006 found a PK with 4-2' straddles
date

- left monument as found
- lowered monument
- removed monument (explain)

On Nov 9, 2006 placed a cim in concrete 0.02' below finish grade
date

SKETCH OF REFERENCE TIES

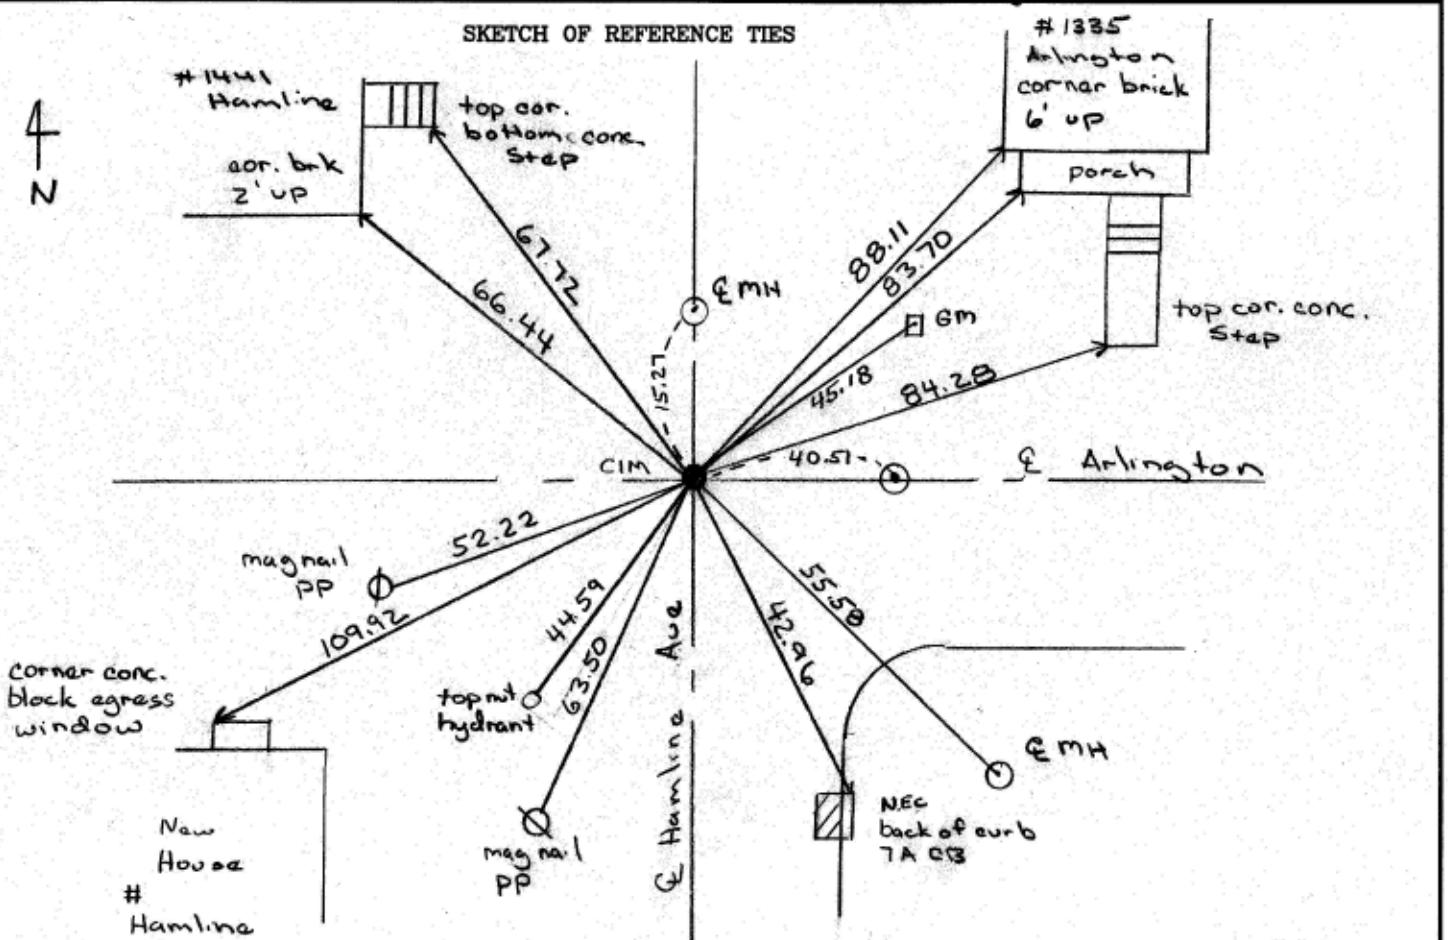

Statement of evidence relative to this corner is available from the St. Paul Public Works Dept., Survey Division RWRL LO

I hereby certify that this document and the data contained herein was prepared by me or under my direct supervision.

Michael P. Murphy 11/16/06
SIGNATURE DATE

Registration No. 41,001

- Land Surveyor
- County Surveyor
- Professional Engineer
- Chief Surveyor, City of St. Paul

Office of The County Recorder, County of Ramsey

I hereby certify that this document was filed in the county
Recorders office at _____ M. on the _____ day of _____

County Recorder _____

By _____, Deputy

DOCUMENT NUMBER _____