


# CERTIFICATE OF LOCATION OF GOVERNMENT CORNER

Center Corner of Section 19, Township 29, Range 22, 4th P.M.  
STATE OF MINNESOTA, County of Ramsey

At the corner location shown on the sketch:

- On 8-3-91 found a Cast iron monument  
DATE  
Took reference ties and removed monument prior to construction
  - left monument as found,  lowered monument,  removed monument (explain)
- On 12-15-92 placed a Cast iron monument to its  
DATE  
original position

### SKETCH OF REFERENCE TIES

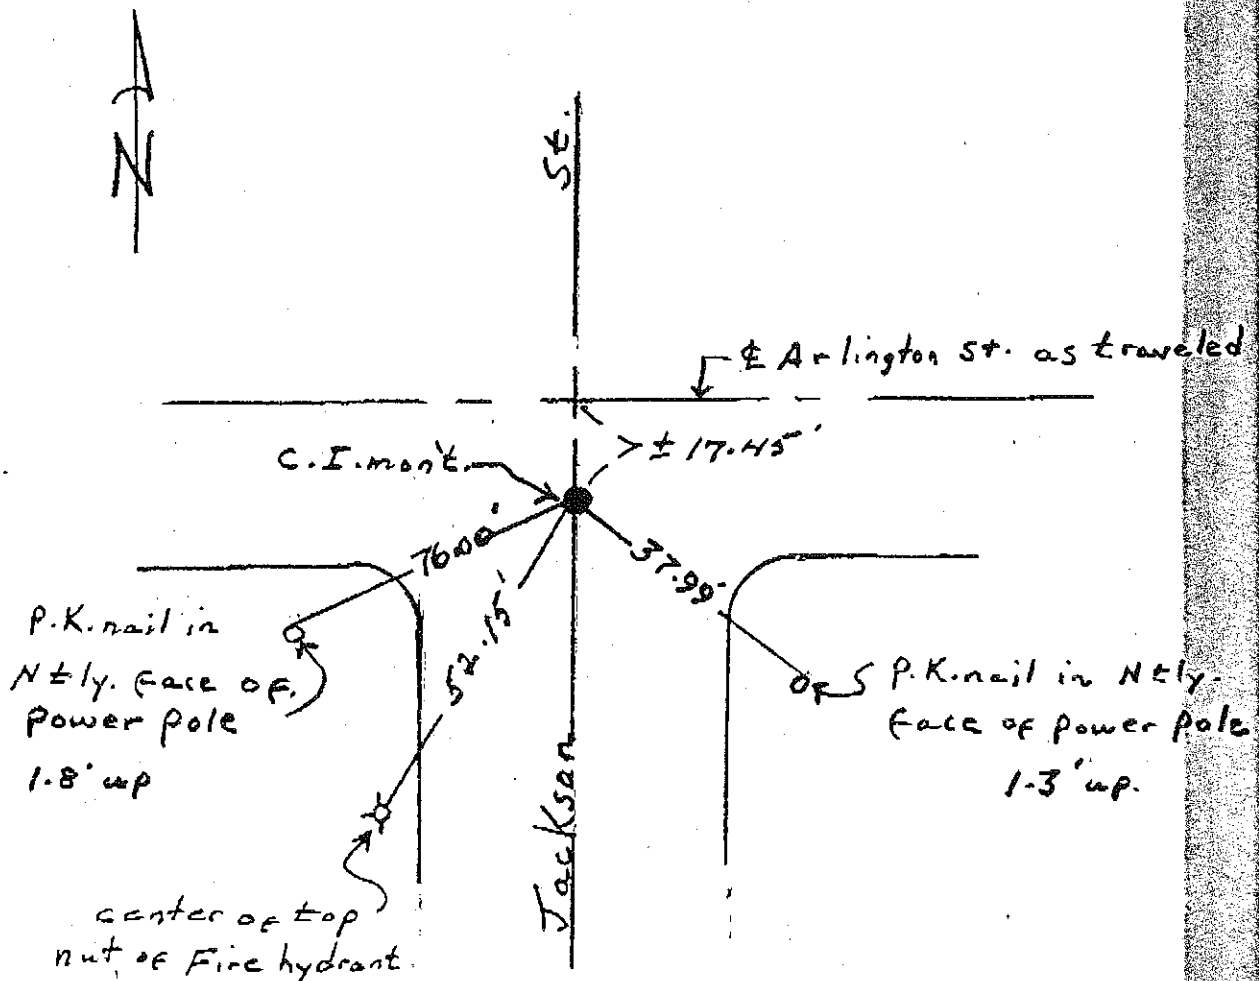

I hereby certify that this document and the data contained herein was prepared by me or under my direct supervision.

Jessie H. Smith 12-15-92  
SIGNATURE DATE

Registration No. 12003  
 Land Surveyor,  Professional Engineer  
 County Surveyor,  County Engineer

OFFICE OF THE COUNTY RECORDER  
County of \_\_\_\_\_

I hereby certify that this document was filed the Co. Recorders office at \_\_\_\_\_ M. on \_\_\_\_\_ day of \_\_\_\_\_ A.D., 19\_\_\_\_

County Recorder \_\_\_\_\_  
By \_\_\_\_\_, Depu  
DOCUMENT NO. \_\_\_\_\_