

CERTIFICATE OF LOCATION OF GOVERNMENT CORNER

1/4 Corner #34 Corner of Section 20, Township 29, Range 22, _____ P.M.

STATE OF MINNESOTA, County of Ramsey


At the corner location shown on the sketch:

On 10-6-92 found a Cast Iron Monument & retied ^{Mont} At Grade
DATE

left monument as found, lowered monument, removed monument (explain)

On _____ placed a _____
DATE

SKETCH OF REFERENCE TIES

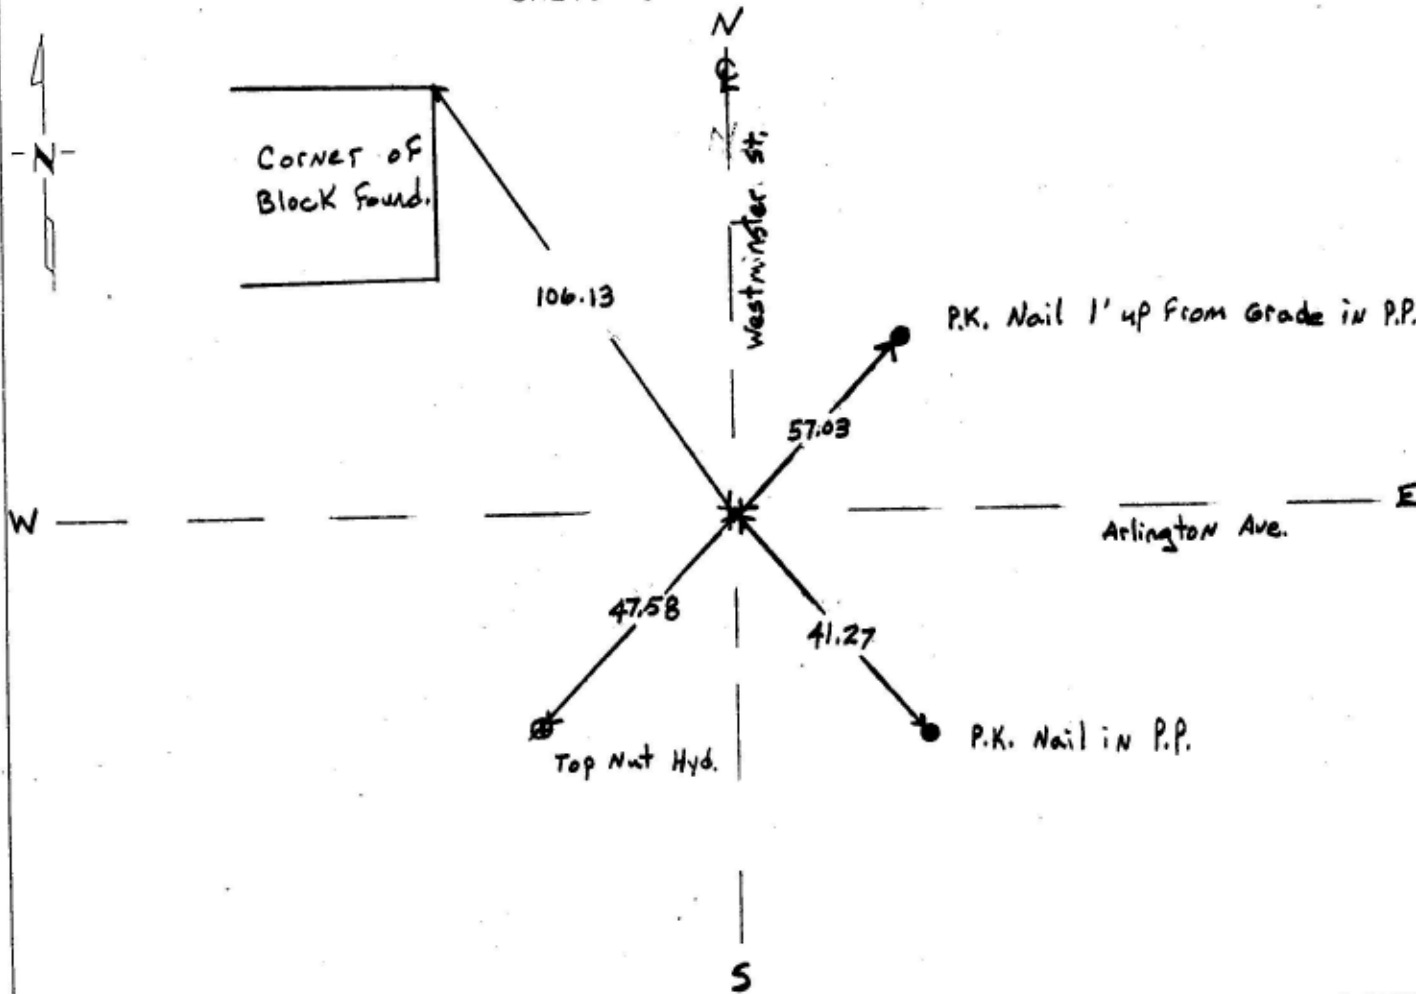

Statement of evidence relative to this corner location is on back of page.

I hereby certify that this document and the data contained herein was prepared by me or under my direct supervision.



06/17/1992
DATE

Registration No. _____

Land Surveyor, Professional Engineer

County Surveyor, County Engineer

OFFICE OF THE COUNTY RECORDER

County of _____

I hereby certify that this document was filed in the Co. Recorders office at _____ M. on the _____ day of _____ A.D., 19 _____

County Recorder _____

By _____, Deputy

DOCUMENT NO. _____
SCANNED 3/4/99 mpm