

CERTIFICATE OF LOCATION OF GOVERNMENT CORNER

1/4 Corner of Section 21, Township 29, Range 22, _____ P.M.

STATE OF MINNESOTA, County of Ramsay


At the corner location shown on the sketch:

On Oct 9, 1992 found a Cast Iron monument set to grade.
DATE

left monument as found, lowered monument, removed monument (explain)

On _____ placed a _____
DATE

SKETCH OF REFERENCE TIES

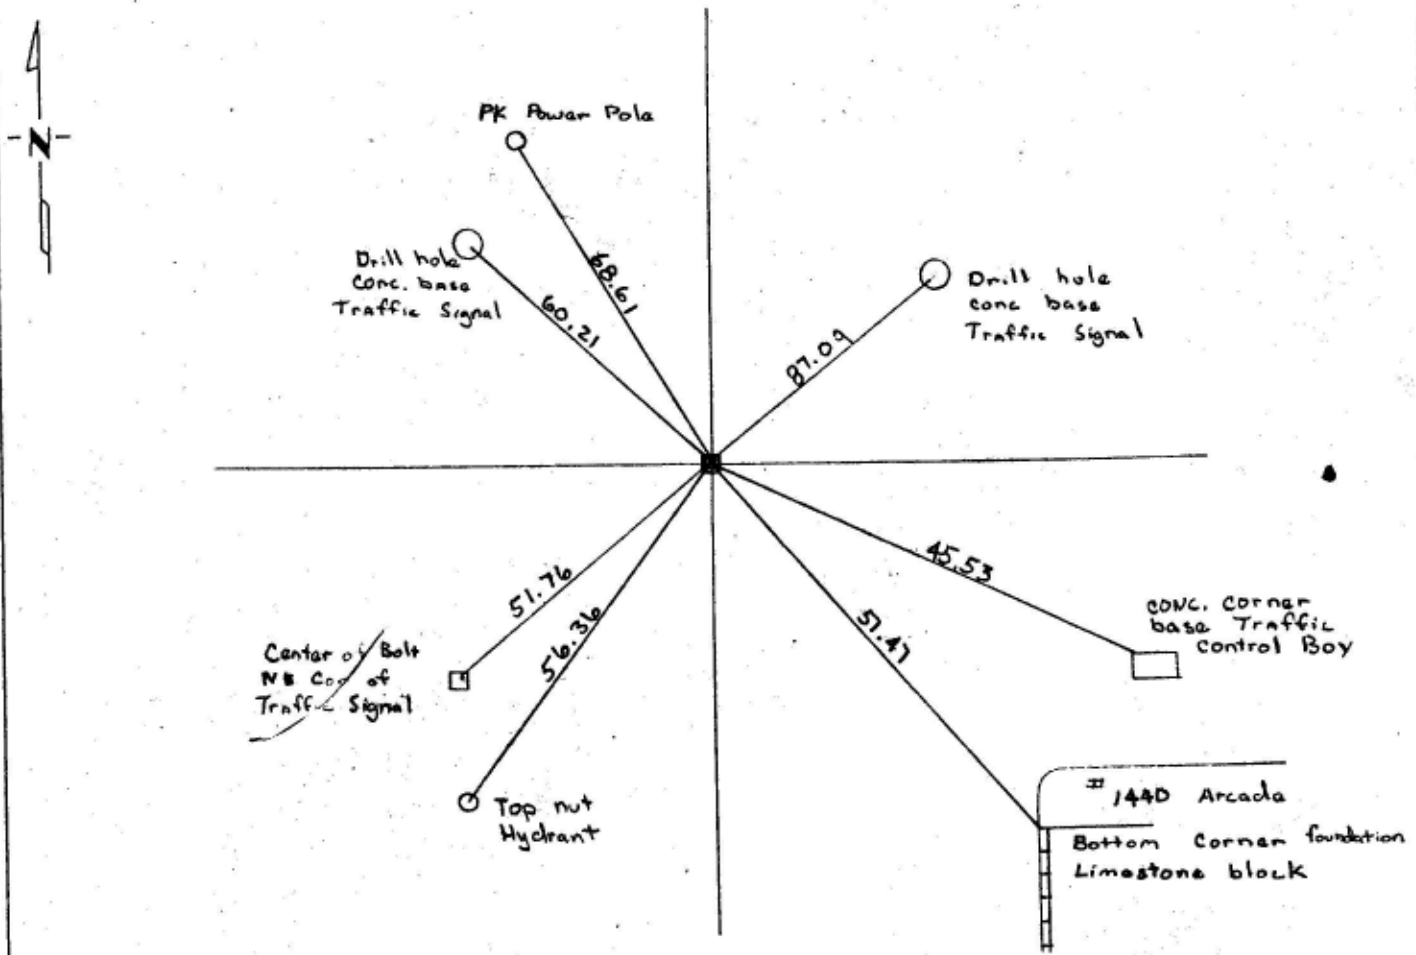


Statement of evidence relative to this corner location is on back of page.

I hereby certify that this monument and the data contained herein was prepared by me or under my direct supervision.

[Signature]

 DATE Oct 16, 1992

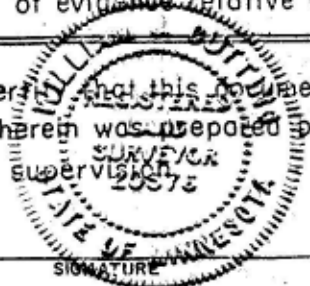

Registration No. _____

Land Surveyor, Professional Engineer

County Surveyor, County Engineer

OFFICE OF THE COUNTY RECORDER
 County of _____

I hereby certify that this document was filed in the Co. Recorders office at _____ M. on the _____ day of _____ A.D., 19 _____

County Recorder _____

By _____, Deputy

DOCUMENT NO. _____