

CERTIFICATE OF LOCATION OF GOVERNMENT CORNER


1/4 CORNER Corner of Section 32, Township 29, Range 22, P.M.

STATE OF MINNESOTA, County of RAMSEY

At the corner location shown on the sketch:


- On 22 OCT 92 found a GRANITE MONUMENT WITH STEEL PIN IN IT
DATE
- left monument as found, lowered monument, removed monument (explain)
- On 22 OCT 92 placed a MOVED STEEL PIN TO PROPER POSITION SEALED WITH CONCRETE
DATE

SKETCH OF REFERENCE TIES

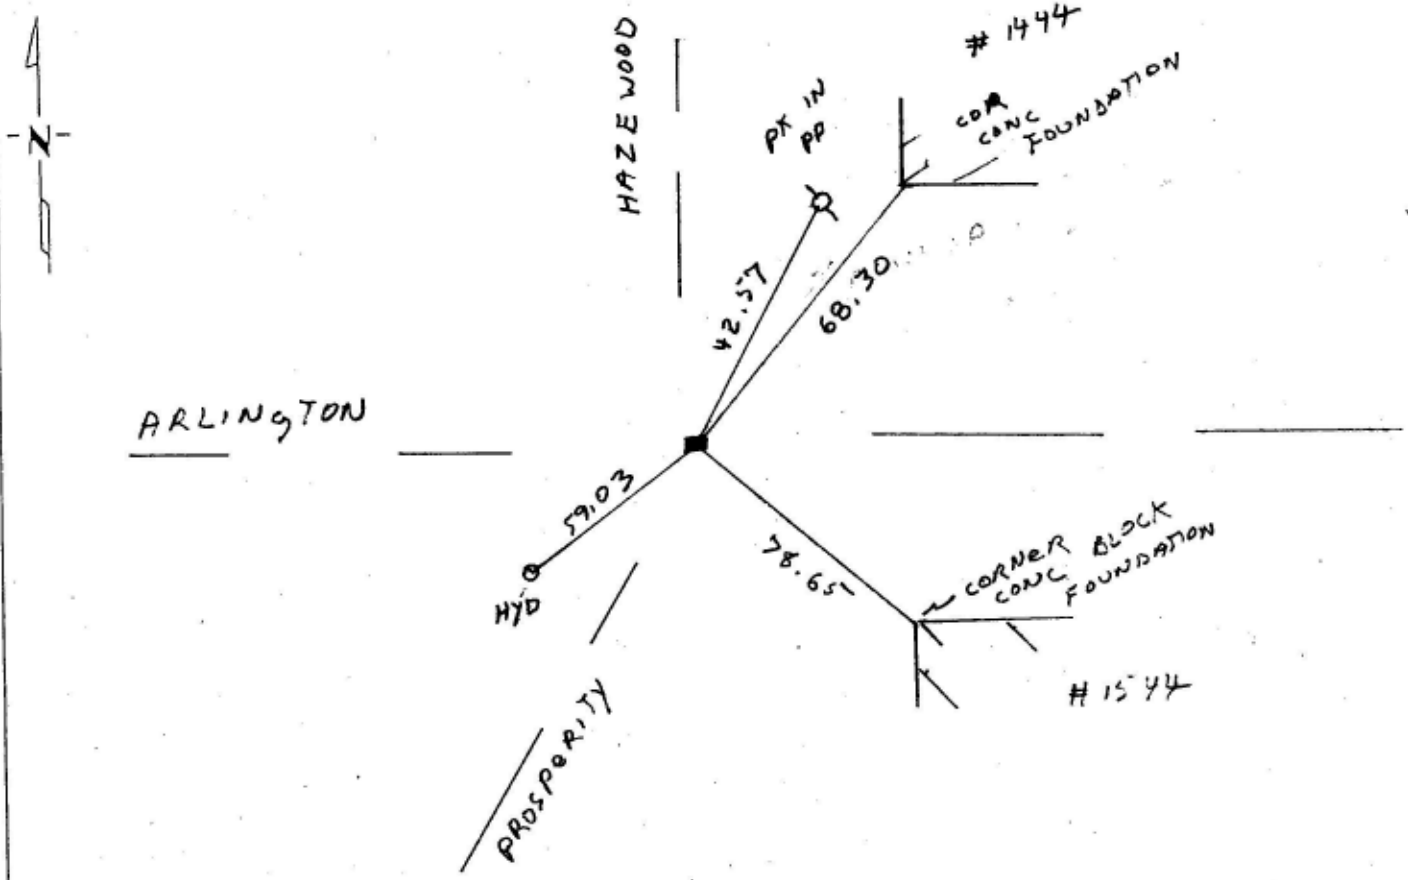

Statement of evidence relative to this corner location is on back of page.

I hereby certify that this document and the data contained hereon were prepared by me or under my direct supervision.

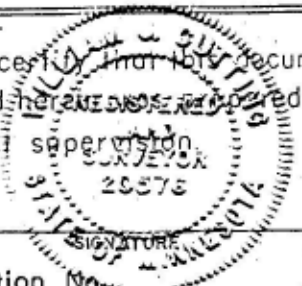

10/23/1992
DATE

Registration No. _____

Land Surveyor, Professional Engineer

County Surveyor, County Engineer

OFFICE OF THE COUNTY RECORDER
County of _____

I hereby certify that this document was filed in the Co. Recorders office at _____ M. on the _____ day of _____ A.D., 19 _____

County Recorder _____
By _____, Deputy

DOCUMENT NO. _____