

CERTIFICATE OF LOCATION OF GOVERNMENT CORNER

City ID: 0041

Old Index #: 1877

Center Corner of Section 23 Township 29 Range 22, 4th P.M.
STATE OF MINNESOTA, County of Ramsey


At the corner location shown on the sketch:

On March 30, 2012 found a CIM 0.5 ft below asphalt surface.

left monument as found lowered monument removed monument (explain)

On _____ placed a _____

SKETCH OF REFERENCE TIES

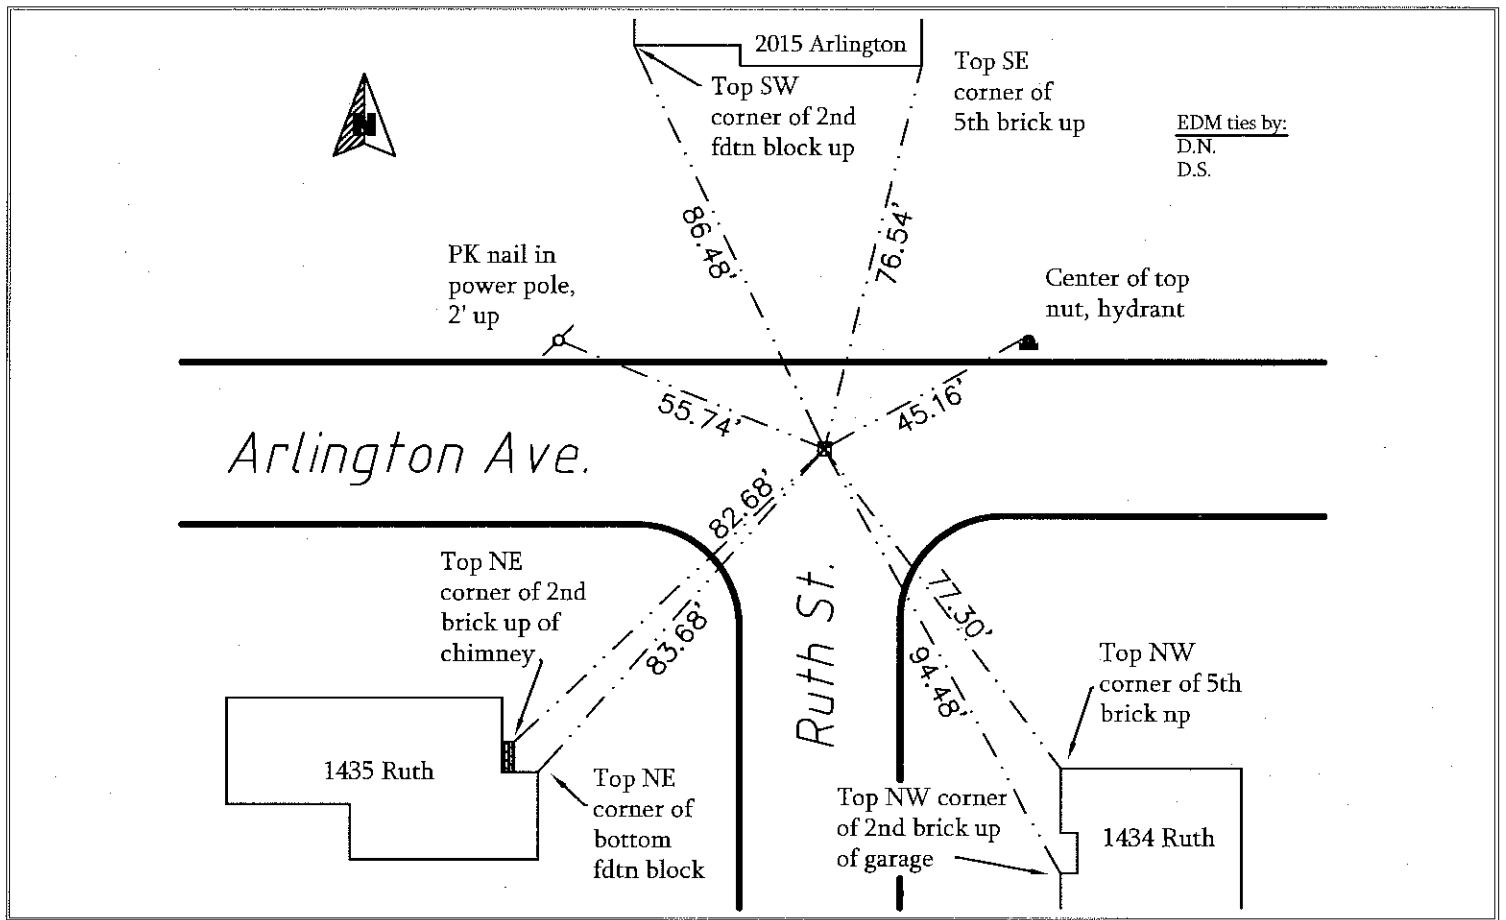

Statement of evidence relative to this corner is available from the St. Paul Public Works Dept., Survey Division

I hereby certify that this document and the data contained herein was prepared by me or under my direct supervision.

[Signature] Aug 31, 2012
Registration No. 44880

- Land Surveyor County Surveyor
- Professional Engineer
- Chief Surveyor, City of St. Paul

Office of the County Recorder, County of Ramsey
I hereby certify that this document was filed in the county recorders office at _____ M. on the _____ day of _____

County Recorder _____

By _____, Deputy

DOCUMENT NUMBER _____