

CERTIFICATE OF LOCATION OF GOVERNMENT CORNER

Corner of Section _____, Township _____, Range _____, _____ P.M.

STATE OF MINNESOTA, County of _____


At the corner location shown on the sketch:

On SEPT 19, 1995 found a CAST IRON MONUMENT .10' BELOW GRADE

left monument as found, lowered monument, removed monument (explain)

On _____ placed a _____

SKETCH OF REFERENCE TIES

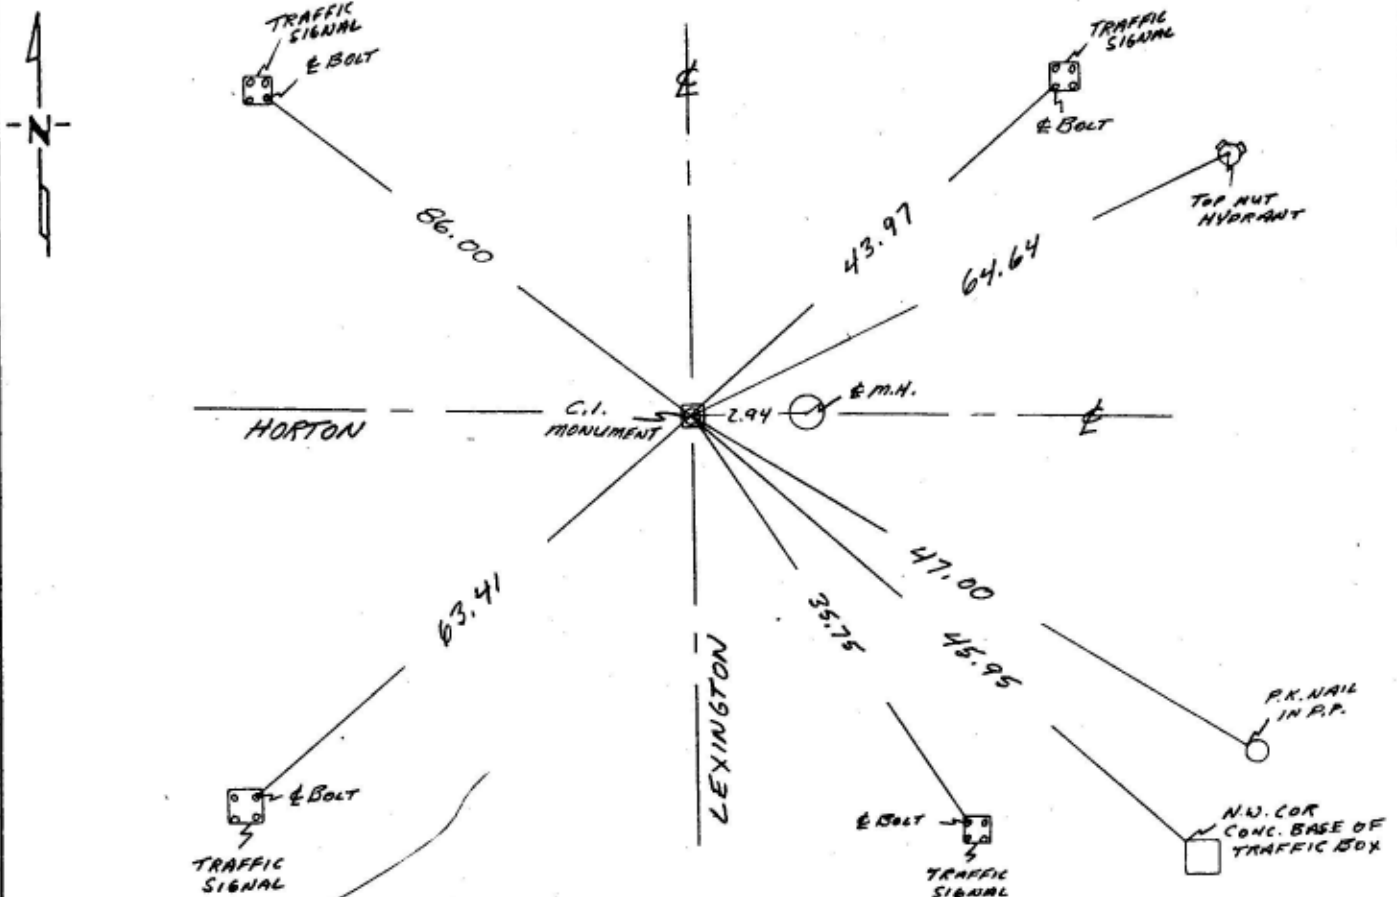

SKETCH BY: K. DARGL 9/19/95

Statement of evidence relative to this corner location is on back of page.

I hereby certify that this document and the data contained herein was prepared by me or under my direct supervision.

William J. [Signature] Sept 17, 1995
SIGNATURE DATE

Registration No. 20096

Land Surveyor, Professional Engineer

OFFICE OF THE COUNTY RECORDER

County of _____

I hereby certify that this document was filed in the Co. Recorders office at _____ .M. on the _____ day of _____ A.D., 19 _____

County Recorder _____

By _____, Deputy

DOCUMENT NO. _____

SCANNED 3/5/99