

# CERTIFICATE OF LOCATION OF GOVERNMENT CORNER

1/4 Corner of Section 28, Township 29, Range 22, \_\_\_\_\_ P.M.

STATE OF MINNESOTA, County of Ramsey


At the corner location shown on the sketch:

On 6-23-93 found a C I M  
DATE

left monument as found,  lowered monument,  removed monument (explain)

On \_\_\_\_\_ placed a \_\_\_\_\_  
DATE

### SKETCH OF REFERENCE TIES

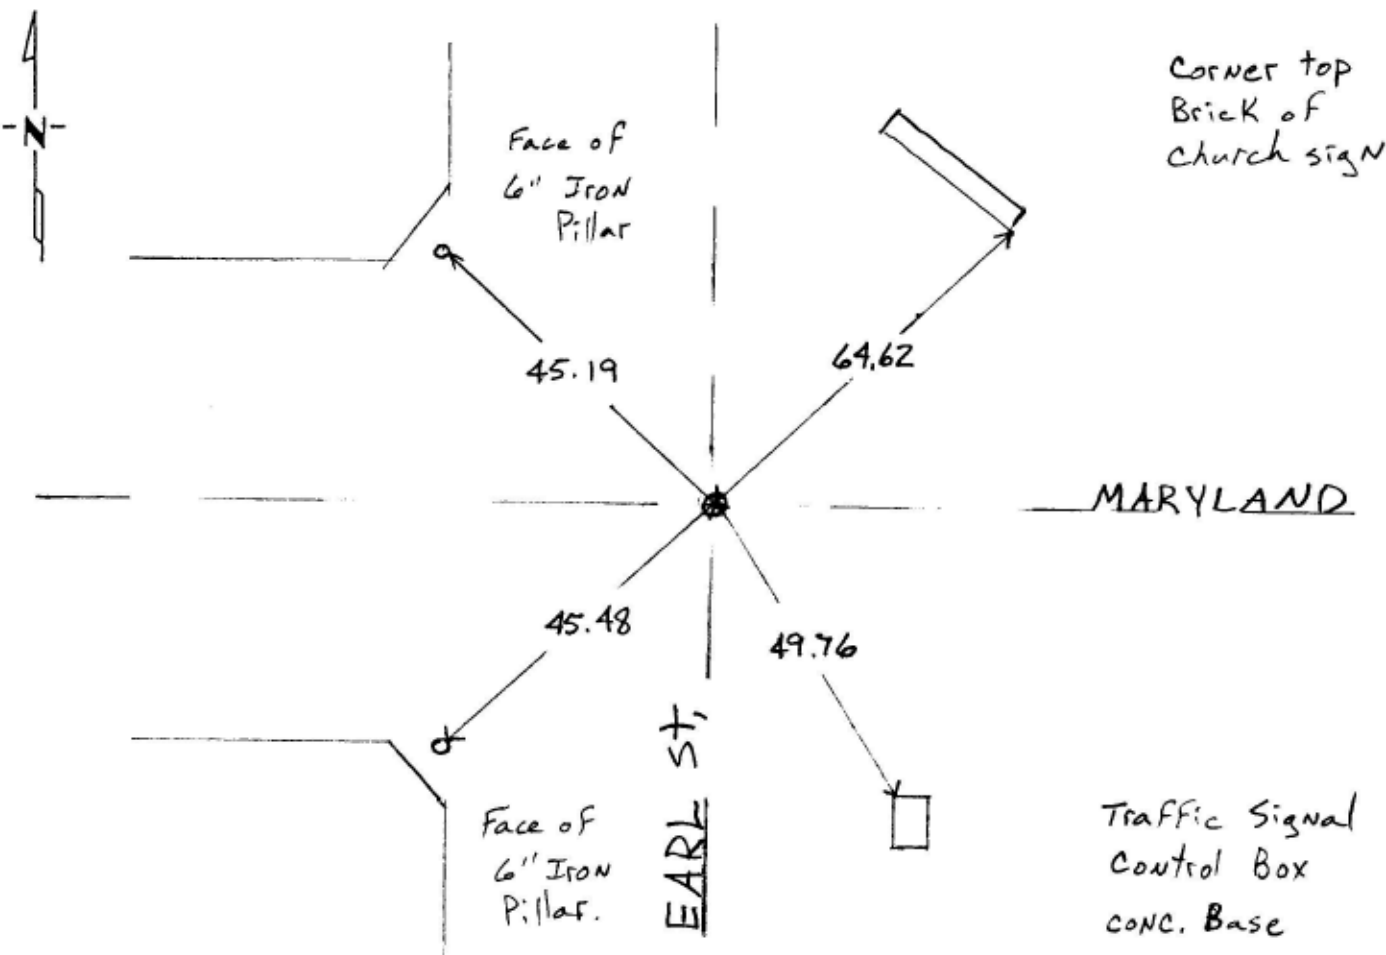

Statement of evidence relative to this corner location is on back of page.

I hereby certify that this document and the data contained herein were prepared by me or under my direct supervision.

\_\_\_\_\_  
SIGNATURE  
June 29 1993  
DATE

Registration No. \_\_\_\_\_  
 Land Surveyor,  Professional Engineer  
 County Surveyor,  County Engineer

### OFFICE OF THE COUNTY RECORDER

County of \_\_\_\_\_

I hereby certify that this document was filed in the Co. Recorders office at \_\_\_\_\_ .M. on the \_\_\_\_\_ day of \_\_\_\_\_ A.D., 19 \_\_\_\_

County Recorder \_\_\_\_\_

By \_\_\_\_\_, Deputy

DOCUMENT NO. \_\_\_\_\_

Scanned 3/11/99 mpm