

# CERTIFICATE OF LOCATION OF GOVERNMENT CORNER

North West Corner of Section 27, Township 29, Range 22 4<sup>th</sup> P.M.

STATE OF MINNESOTA, County of Ramsey


At the corner location shown on the sketch:

On \_\_\_\_\_ found a \_\_\_\_\_

left mon. as found     lowered mon.     removed mon.(explain)


On April 29 placed a Concrete Mont

## SKETCH OF REFERENCE TIES

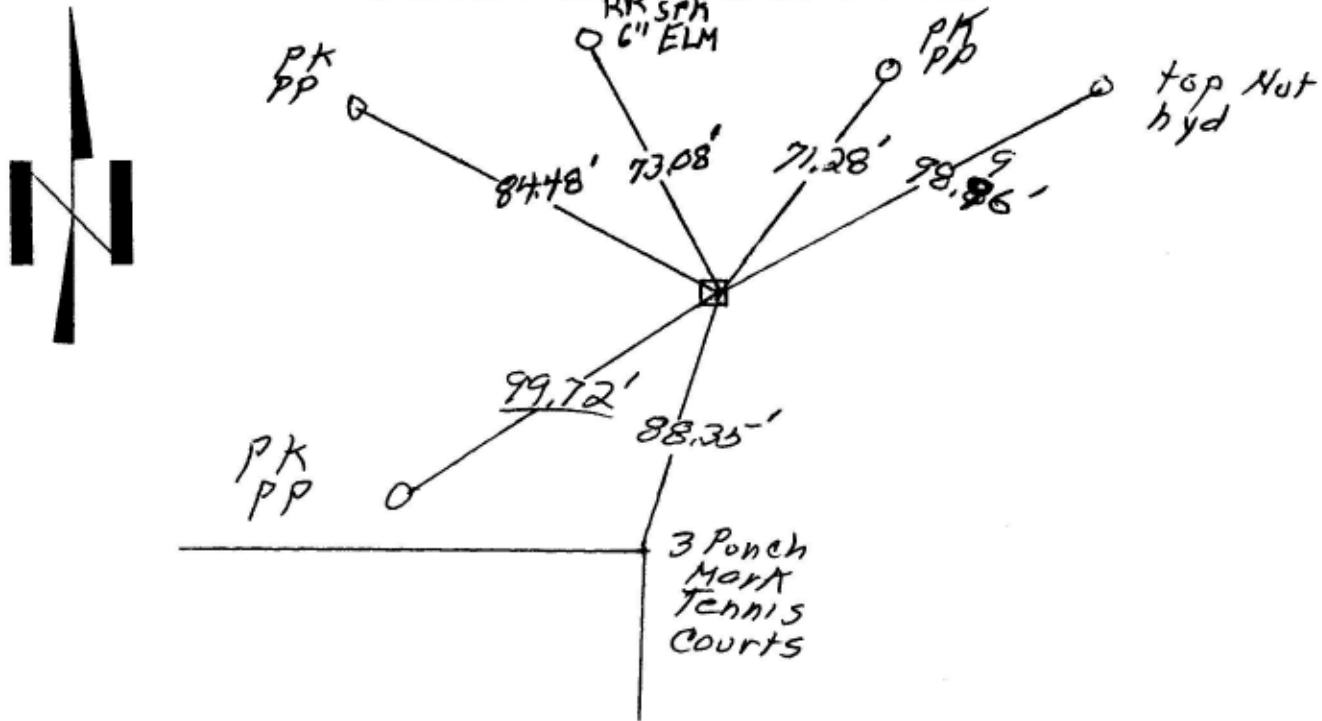

Statement of evidence relative to this corner location is on back of page

I hereby certify that this document and the date contained herein was prepared by me or under my supervision.

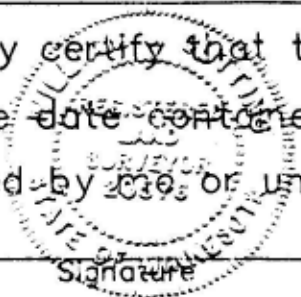

Signature

date April 29, 1922

Registration No. \_\_\_\_\_

Land Surveyor     Professional Engineer

County Surveyor     County Engineer

Office of the Register of Deeds  
County of \_\_\_\_\_

I hereby certify that this document was filed in the Reg. of Deeds office at \_\_\_\_\_ M.

on the \_\_\_\_\_ day of \_\_\_\_\_ A.D., 19\_\_

Register of Deeds \_\_\_\_\_ By \_\_\_\_\_

DOCUMENT NO. \_\_\_\_\_