

old Index 664

CERTIFICATE OF LOCATION OF GOVERNMENT CORNER


60 1/4 Corner of Section 22, Township 29, Range 22, 4th P.M.

STATE OF MINNESOTA, County of Ramsay

At the corner location shown on the sketch:


- On _____ found a _____
DATE
- left monument as found, lowered monument, removed monument (explain)
- On Sept 10, 1991 placed a cast iron monument set to grade
DATE

SKETCH OF REFERENCE TIES

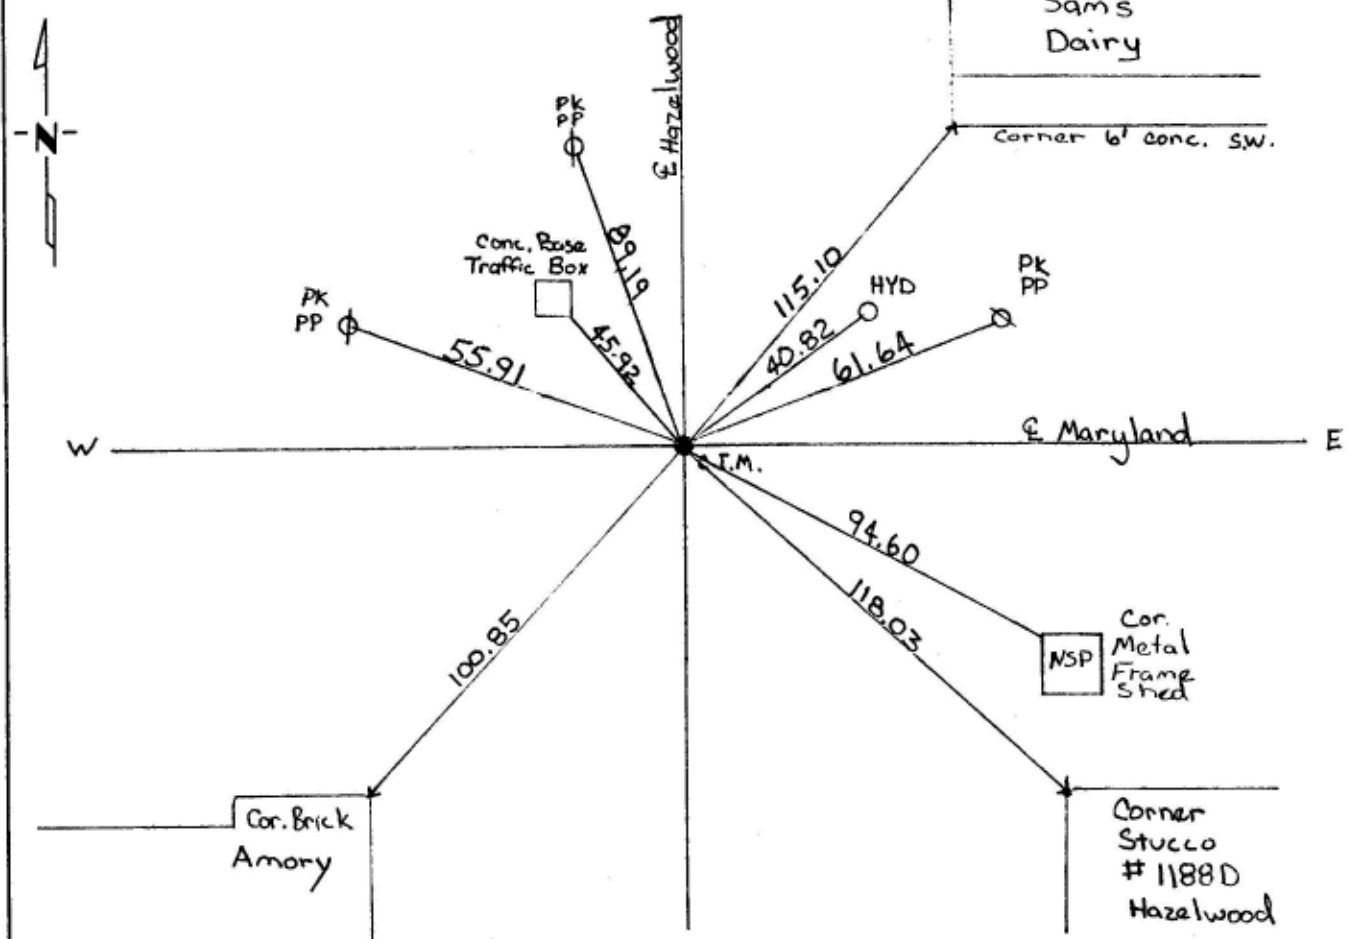

Statement of evidence relative to this corner location is on back of page.

I hereby certify that this document and the data contained herein was prepared by me or under my direct supervision.

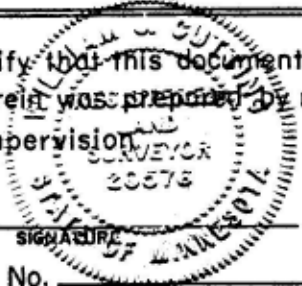

DATE 9-13-1991

- Registration No. _____
- Land Surveyor, Professional Engineer
 - County Surveyor, County Engineer

OFFICE OF THE COUNTY RECORDER
County of _____

I hereby certify that this document was filed in the Co. Recorders office at _____ .M. on the _____ day of _____ A.D., 19 _____

County Recorder _____
By _____, Deputy
DOCUMENT NO. _____