

CERTIFICATE OF LOCATION OF GOVERNMENT CORNER

CITY MON. NO. 0064

OLD INDEX NO. 1057

1/4 Corner of Section 29 < 30 Township 29 Range 23, 4 P.M.


STATE OF MINNESOTA, County of Ramsey

At the corner location shown on the sketch:

On Jan 24, 2008 found a CRM at grass grade
date

left monument as found lowered monument removed monument (explain)

On _____ placed a _____
date

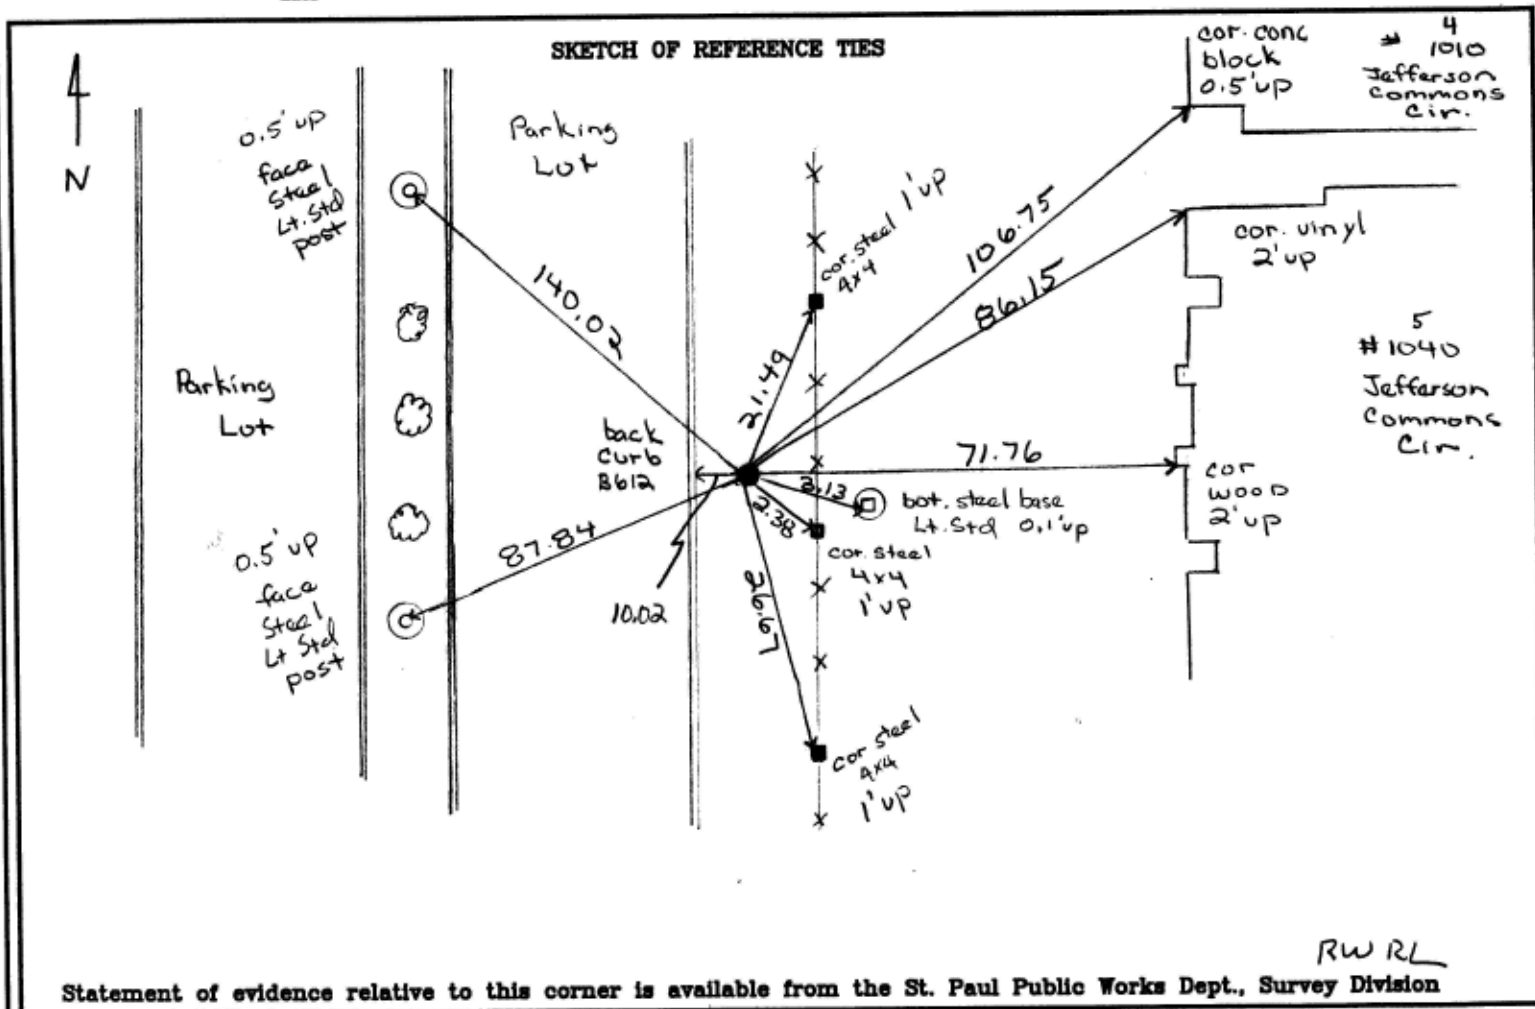

Statement of evidence relative to this corner is available from the St. Paul Public Works Dept., Survey Division

I hereby certify that this document and the data contained herein was prepared by me or under my direct supervision.

[Signature]
SIGNATURE

FEB 12, 2008
DATE

Registration No. 44880

- Land Surveyor County Surveyor
- Professional Engineer
- Chief Surveyor, City of St. Paul

Office of The County Recorder, County of Ramsey

I hereby certify that this document was filed in the county

Recorders office at _____ M. on the _____ day of _____

County Recorder _____

By _____, Deputy

DOCUMENT NUMBER _____