

CERTIFICATE OF MONUMENT LOCATION

CITY MON. NO. 0065

OLD INDEX NO. 1054

CEN. 1/4 Corner in the CEN. Qtr. of Section 29 Township 29 Range 23

STATE OF MINNESOTA, County of Ramsey


At the corner location shown on the sketch:

On 10-22-2011 found a GM W/ PK IN CENTER @ RAYMOND ! E. GUT LINE
date

CENTER LINE OF ALLEY

- left monument as found - NOTE lowered monument removed monument (explain)

On 10-24-2011 placed a CASTING OVER GM - RE-TIED - PHOTOS
date

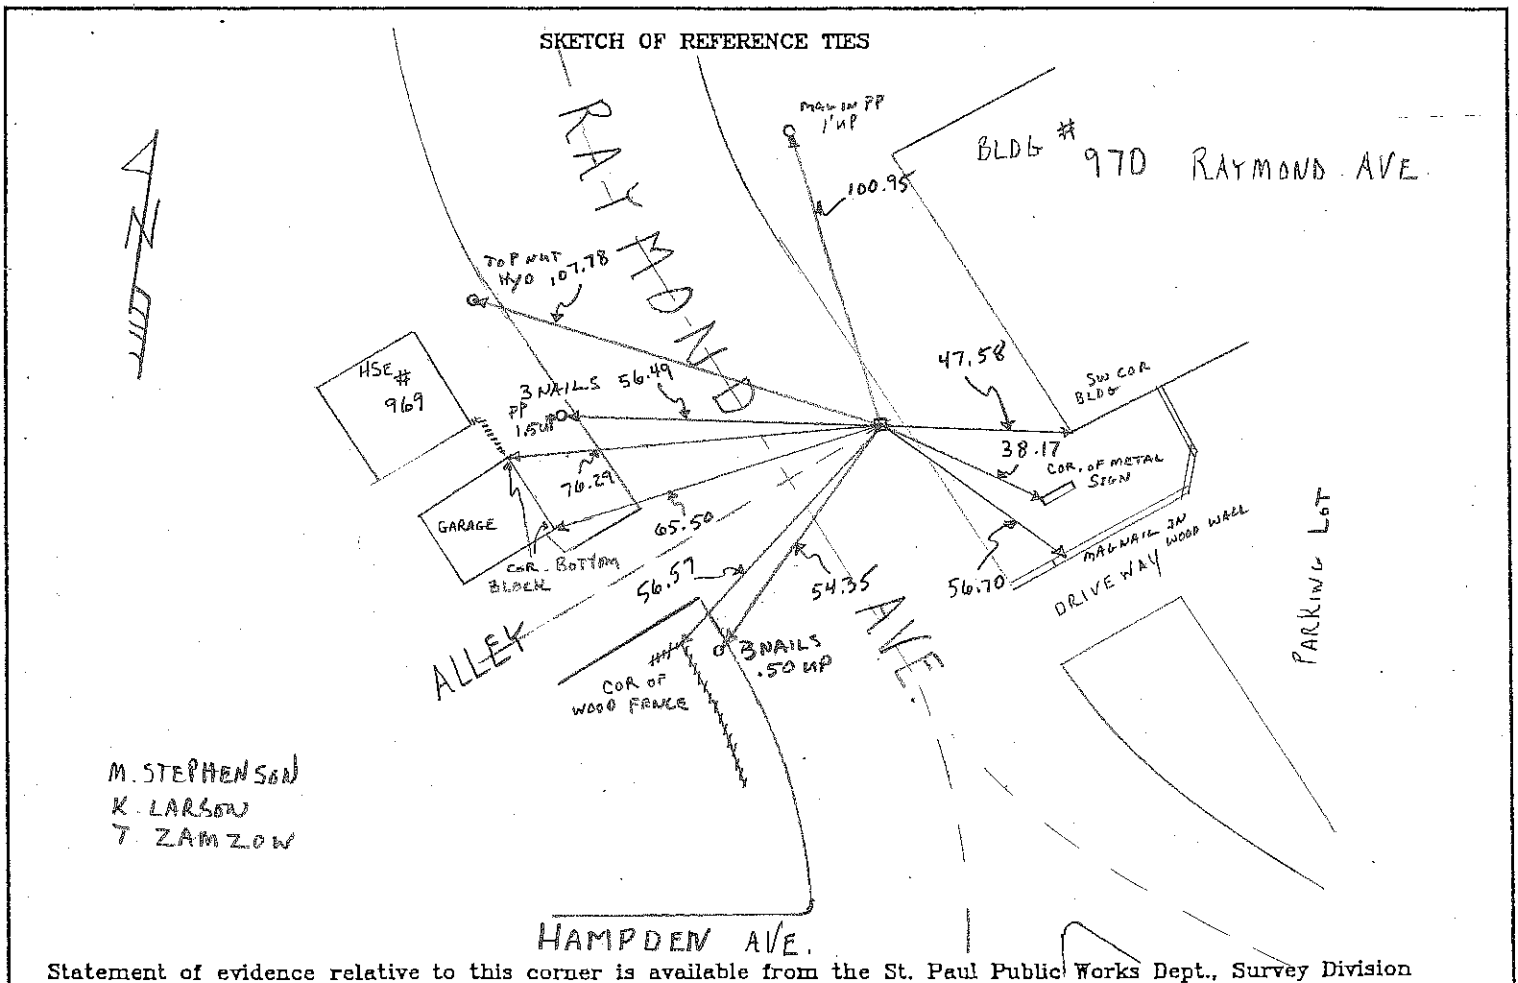

M. STEPHENSON
K. LARSON
T. ZAMZOW

Statement of evidence relative to this corner is available from the St. Paul Public Works Dept., Survey Division

I hereby certify that this document and the data contained herein was prepared by me or under my direct supervision.

[Signature] Aug 17, 2012
SIGNATURE DATE

- Registration No. 44880
- Land Surveyor County Surveyor
- Professional Engineer
- Chief Surveyor, City of St. Paul

Office of The County Recorder, County of Ramsey

I hereby certify that this document was filed in the county
Recorders office at _____ M. on the _____ day of _____

County Recorder _____

By _____, Deputy

DOCUMENT NUMBER _____