

CERTIFICATE OF LOCATION OF GOVERNMENT CORNER

City ID: 0071

Old Index #: 0033

CENTER Corner of Section 26 Township 29 Range 23, 4th P.M.

STATE OF MINNESOTA, County of Ramsey

At the corner location shown on the sketch:


On Nov. 19, 2012 found a PK nail at street grade.

Note: ties collected using steel tape and confirmed with EDM.

left monument as found lowered monument removed monument (explain)

On _____ placed a _____

SKETCH OF REFERENCE TIES

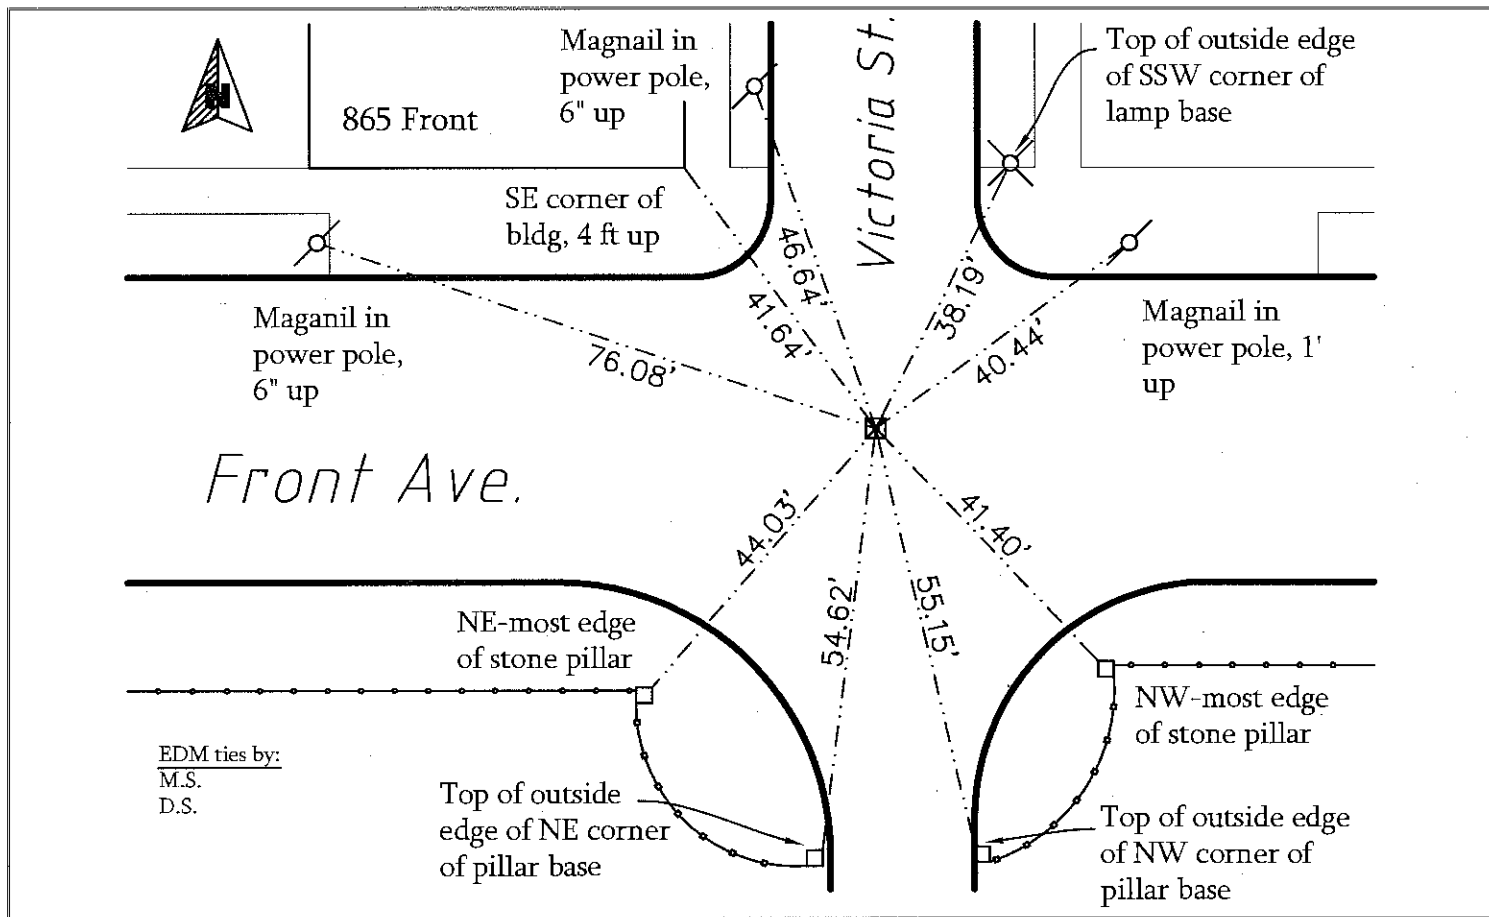

Statement of evidence relative to this corner is available from the St. Paul Public Works Dept., Survey Division

I hereby certify that this document and the data contained herein was prepared by me or under my direct supervision.

[Signature]
Registration No. 44880

- Land Surveyor County Surveyor
- Professional Engineer
- Chief Surveyor, City of St. Paul

Office of the County Recorder, County of Ramsey
I hereby certify that this document was filed in the county recorders office at _____ M. on the _____ day of _____

County Recorder _____

By _____, Deputy

DOCUMENT NUMBER _____