

CERTIFICATE OF LOCATION OF GOVERNMENT CORNER

Center _____ Corner of Section 25, Township 29, Range 23, 4th P.M.

STATE OF MINNESOTA, County of Ramsey


At the corner location shown on the sketch:

On July 31/1991 found a Steel Pin At Grade

left mon. as found lowered mon. removed mon.(explain)

On _____ placed a _____

SKETCH OF REFERENCE TIES

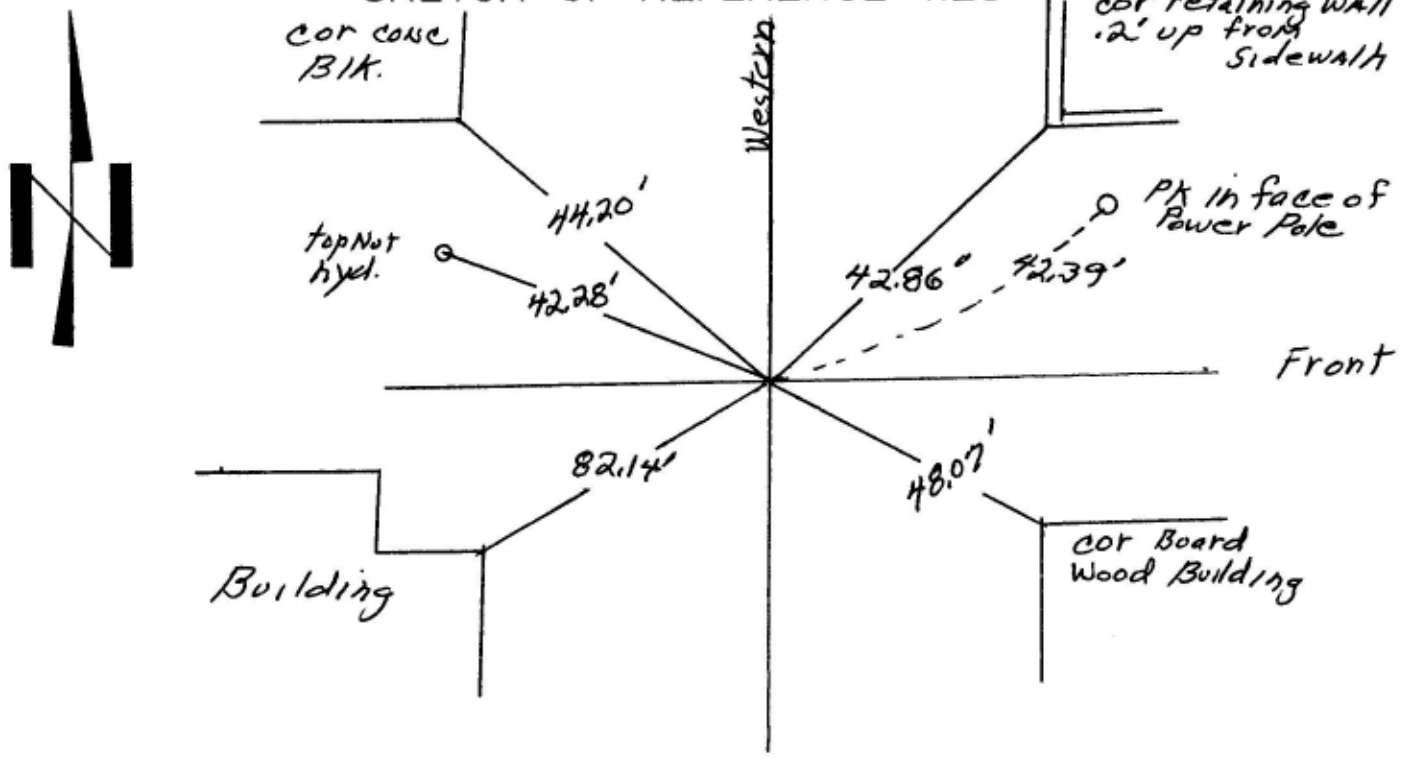

Statement of evidence relative to this corner location is on back of page.

I hereby certify that this document and the data contained herein was prepared by me or under my supervision.

William J. Cutting Signature 8-02-1991 date

Registration No. 20576

Land Surveyor Professional Engineer
 County Surveyor County Engineer

Office of the Register of Deeds
County of _____

I hereby certify that this document was filed in the Reg. of Deeds office at _____ M. on the _____ day of _____ A.D., 19____
Register of Deeds _____ By _____

DOCUMENT NO. _____

Scanned 4/30/99