

# CERTIFICATE OF LOCATION OF GOVERNMENT CORNER

East 1/4 Corner of Section 25, Township 29, Range 23, 4<sup>th</sup> P.M.


STATE OF MINNESOTA, County of Ramsey

At the corner location shown on the sketch:

On 8/6/1991 found a Granite Monument 0.1' below App. 30' @ North on Range Line

left mon. as found     lowered mon.     removed mon. (explain)

On \_\_\_\_\_ placed a \_\_\_\_\_

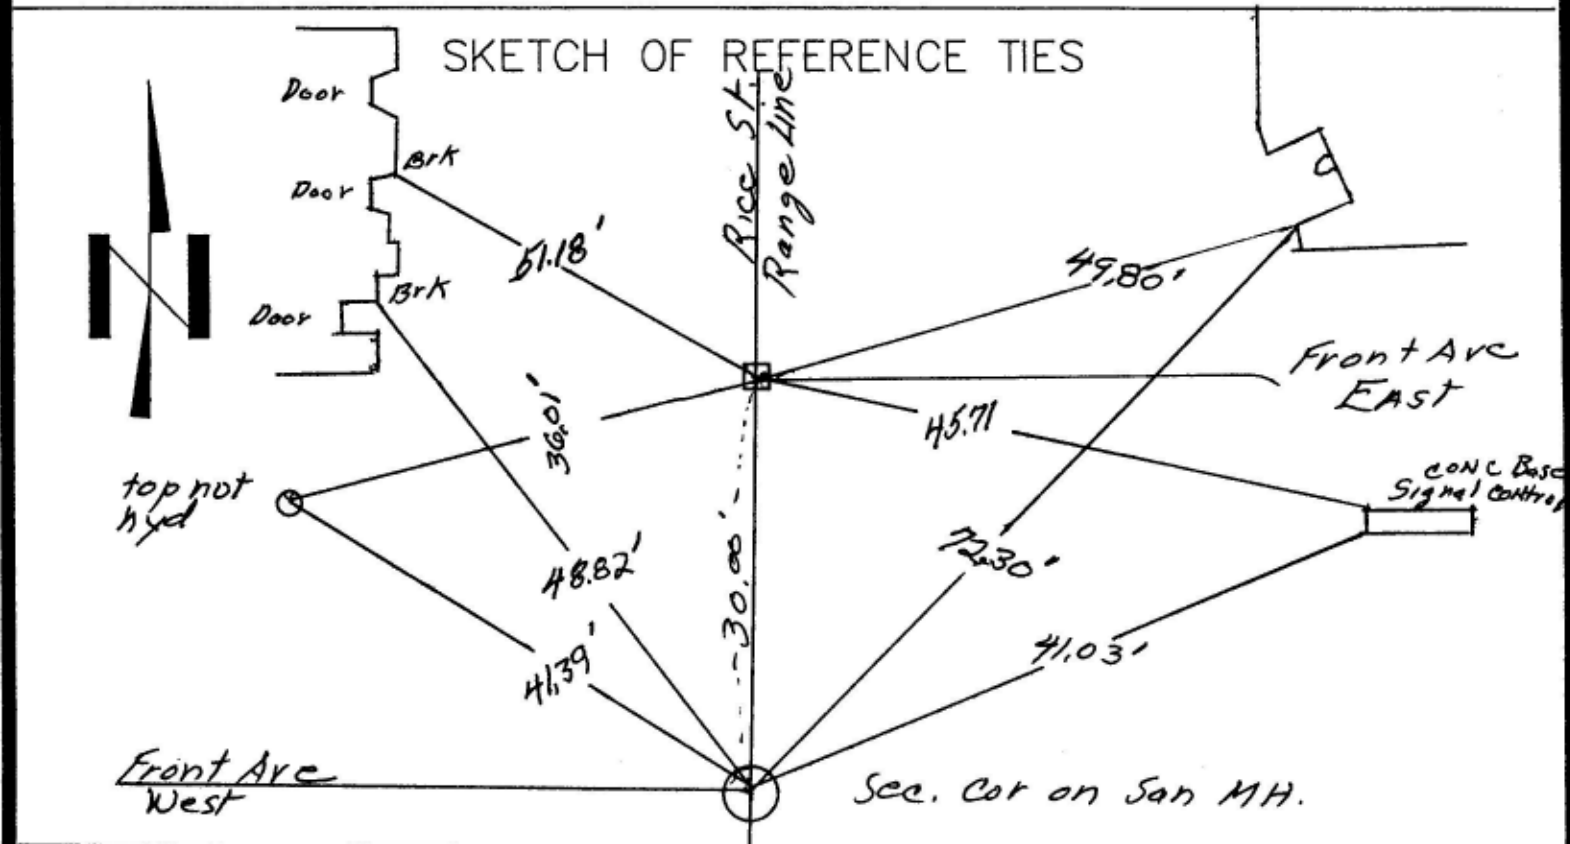

Statement of evidence relative to this corner location is on back of page.

I hereby certify that this document and the date contained herein was prepared by me or under my supervision.

William J. Cuthbert Signature      8/05/1991 date

Registration No. 20576  
 Land Surveyor     Professional Engineer  
 County Surveyor     County Engineer

Office of the Register of Deeds  
County of \_\_\_\_\_

I hereby certify that this document was filed in the Reg. of Deeds office at \_\_\_\_\_ M. on the \_\_\_\_\_ day of \_\_\_\_\_ A.D., 19\_\_\_\_  
Register of Deeds \_\_\_\_\_ By \_\_\_\_\_

DOCUMENT NO. \_\_\_\_\_