


# CERTIFICATE OF LOCATION OF GOVERNMENT CORNER

Center Corner of Section 30, Township 29, Range 22, \_\_\_\_\_ P.M.  
STATE OF MINNESOTA, County of RAMSEY

At the corner location shown on the sketch:


- On 14 OCT 92 found a IRON PIN  
DATE
- left monument as found,  lowered monument,  removed monument (explain)
- On 14 OCT 92 placed a CAST IRON MONUMENT  
DATE

SKETCH OF REFERENCE TIES

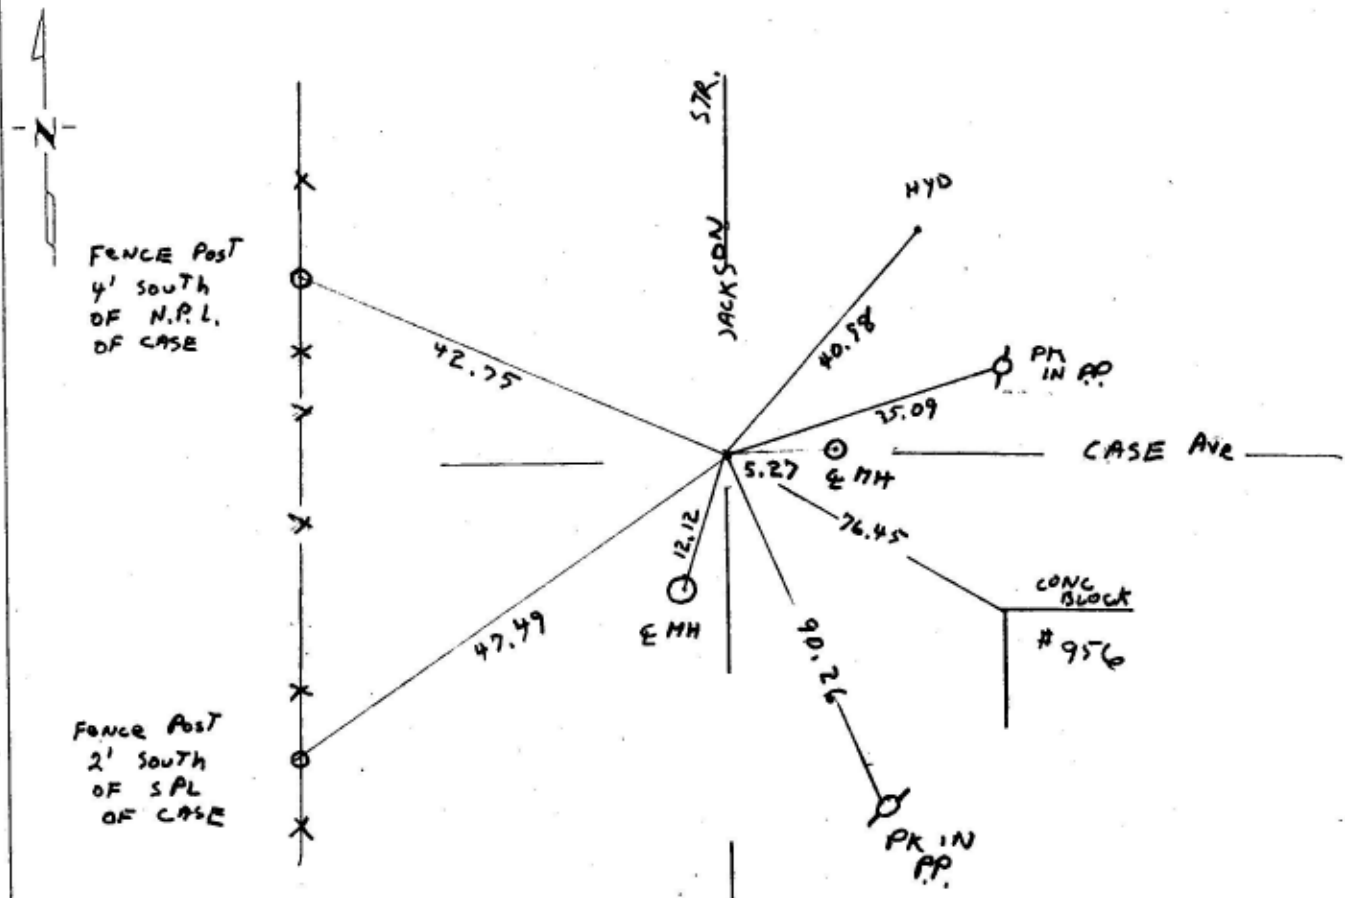

Statement of evidence relative to this corner location is on back of page.

I hereby certify that this document and the data contained herein was prepared by me or under my direct supervision.

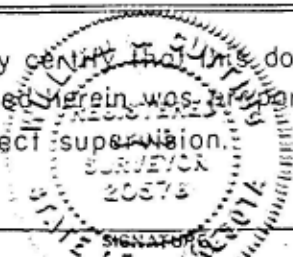

Oct 16, 1992  
DATE

Registration No. \_\_\_\_\_

- Land Surveyor,  Professional Engineer
- County Surveyor,  County Engineer

OFFICE OF THE COUNTY RECORDER

County of \_\_\_\_\_

I hereby certify that this document was filed in the Co. Recorders office of \_\_\_\_\_ M. on the \_\_\_\_\_ day of \_\_\_\_\_ A.D., 19 \_\_\_\_\_

County Recorder \_\_\_\_\_

By \_\_\_\_\_, Deputy

DOCUMENT NO. \_\_\_\_\_

Scanned 4/30/99