

CERTIFICATE OF LOCATION OF GOVERNMENT CORNER

CITY MON. NO. 0077

OLD INDEX NO. 0045A

0077-0045-A.pdf


CENTER Corner of Section 29 Township 29 Range 22, 4th P.M.

STATE OF MINNESOTA, County of Ramsey
At the corner location shown on the sketch:

On Nov 19 2012 found a CIM AT STREET GRADE
date

- left monument as found lowered monument removed monument (explain)

On _____ placed a _____
date

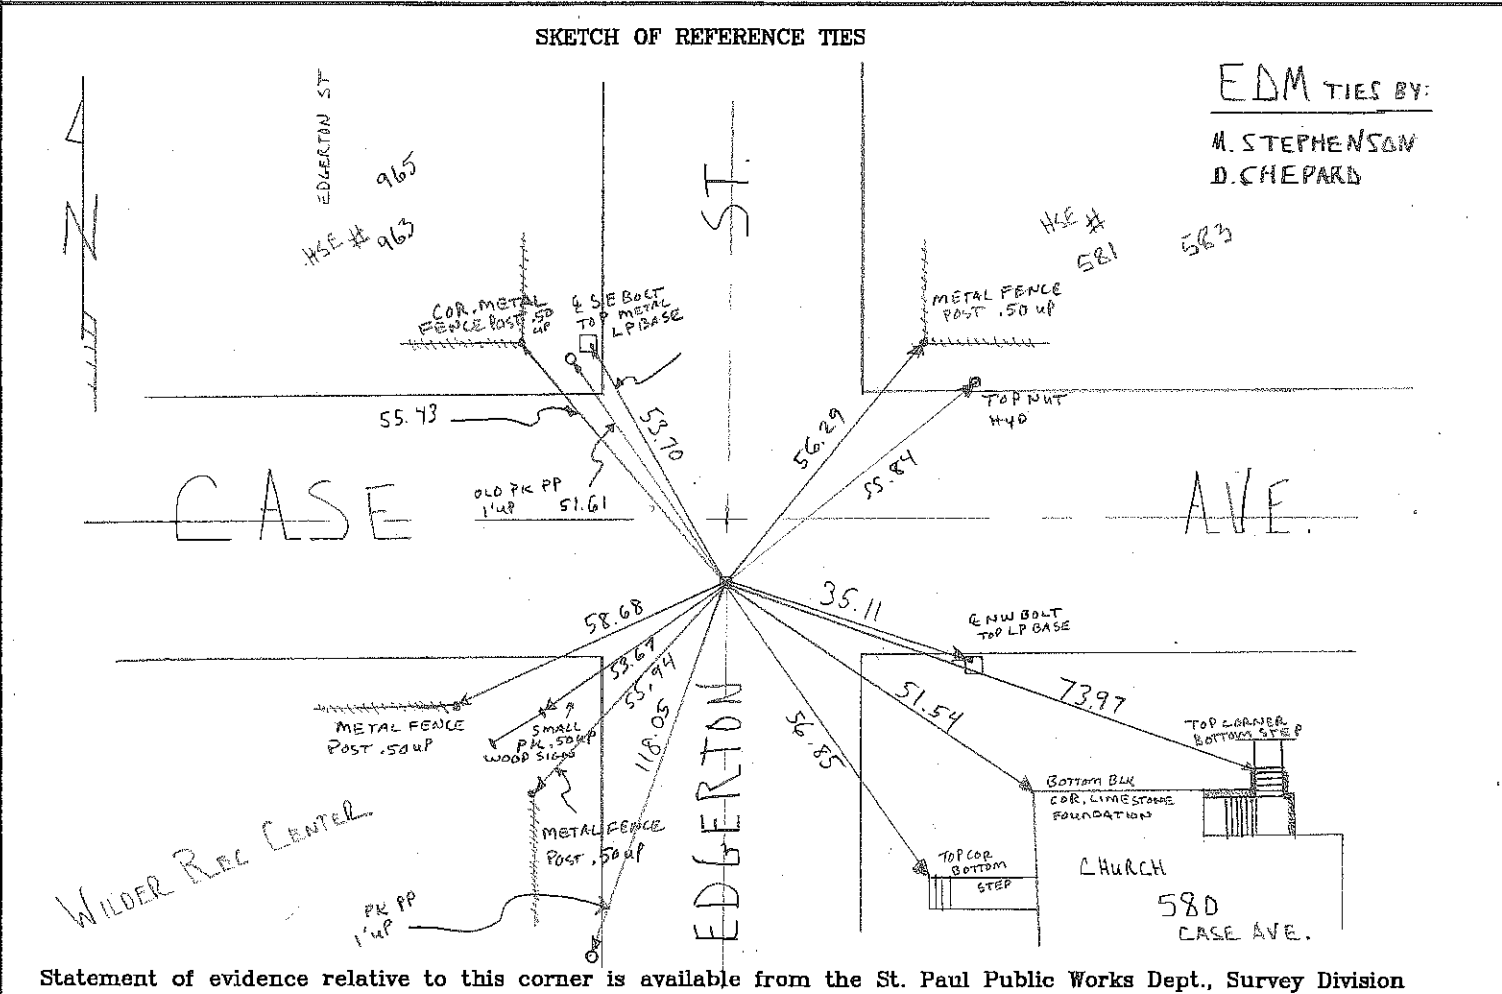

I hereby certify that this document and the data contained herein was prepared by me or under my direct supervision.

[Signature] Dec 24, 2012
SIGNATURE DATE

- Registration No. 44880
- Land Surveyor County Surveyor
- Professional Engineer
- Chief Surveyor, City of St. Paul

Office of The County Recorder, County of Ramsey

I hereby certify that this document was filed in the county
Recorders office at _____ M. on the _____ day of _____

County Recorder _____

By _____, Deputy

DOCUMENT NUMBER _____