

CERTIFICATE OF LOCATION OF GOVERNMENT CORNER


EAST 1/4 Corner of Section 27, Township 29, Range 22, 4TH P.M.

STATE OF MINNESOTA, County of RAMSEY

At the corner location shown on the sketch:

- On OCT 24, 1995 found a GRANITE MONUMENT @ GRADE
DATE
MONUMENT IS 1.6' NORTH OF WITNESS POST AS FOUND THIS DATE
 left monument as found, lowered monument, removed monument (explain)
- On _____ placed a _____
DATE

SKETCH OF REFERENCE TIES

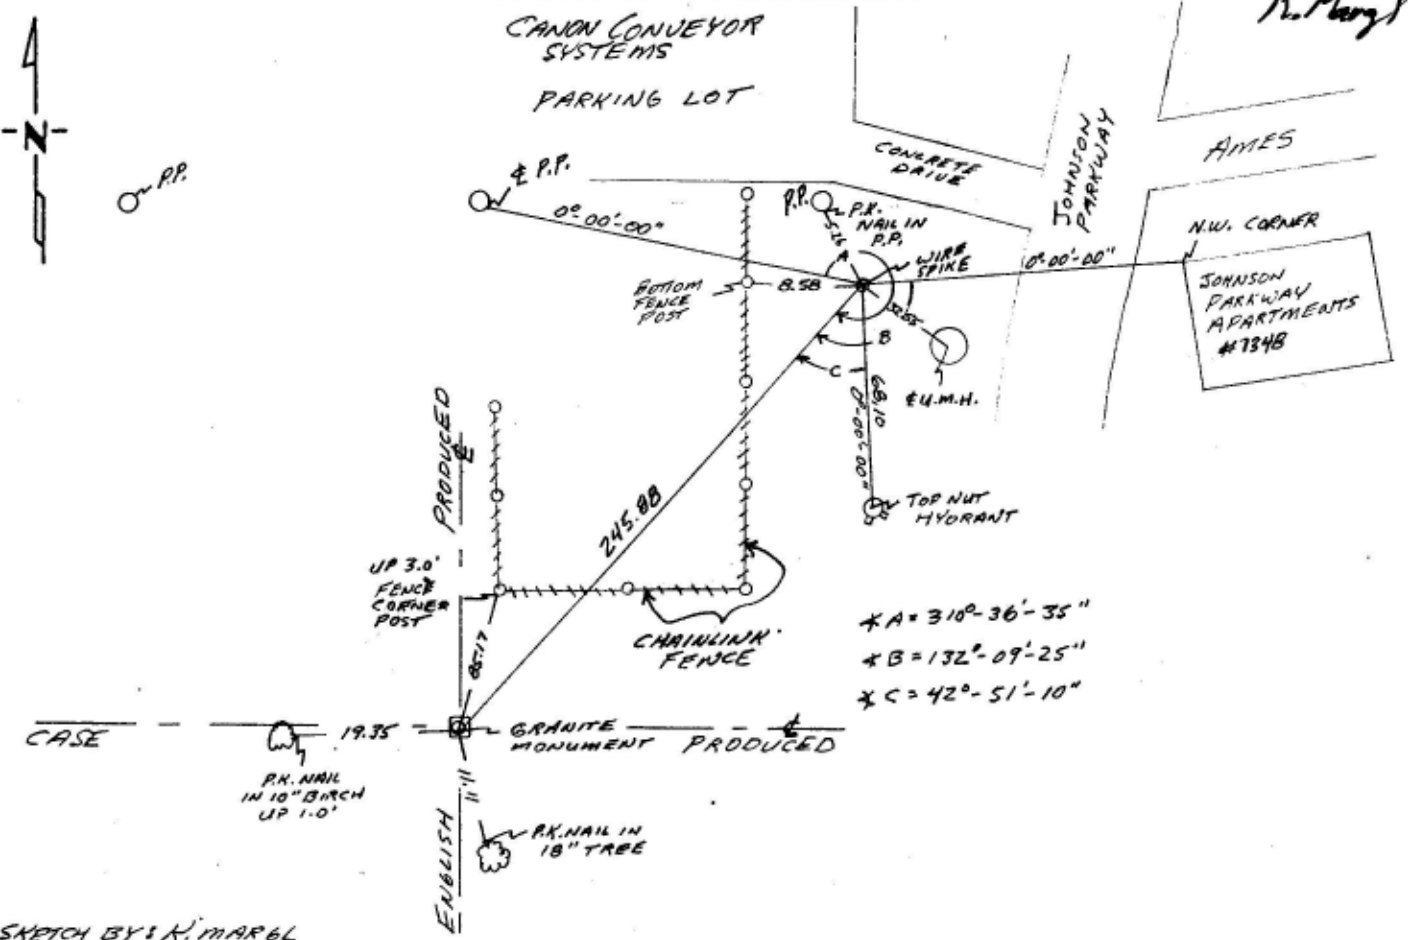

Statement of evidence relative to this corner location is on back of page.

I hereby certify that this document and the data contained herein was prepared by me or under my direct supervision.

William J. Cushing Oct 27, 1998
SIGNATURE DATE

Registration No. _____
 Land Surveyor Professional Engineer
 County Surveyor, County Engineer

OFFICE OF THE COUNTY RECORDER
 County of _____

I hereby certify that this document was filed in the Co. Recorders office at _____ M. on the _____ day of _____ A.D., 19 _____

County Recorder _____
 By _____, Deputy
 DOCUMENT NO. _____