

CERTIFICATE OF LOCATION OF GOVERNMENT CORNER


1/4 CORNER Corner of Section 27, Township 29, Range 22, P.M.

STATE OF MINNESOTA, County of RAMSEY

At the corner location shown on the sketch:

- On _____ found a _____
DATE
- left monument as found, lowered monument, removed monument (explain)
- On 1 OCT 92 placed a CAST IRON MONUMENT
DATE

SKETCH OF REFERENCE TIES

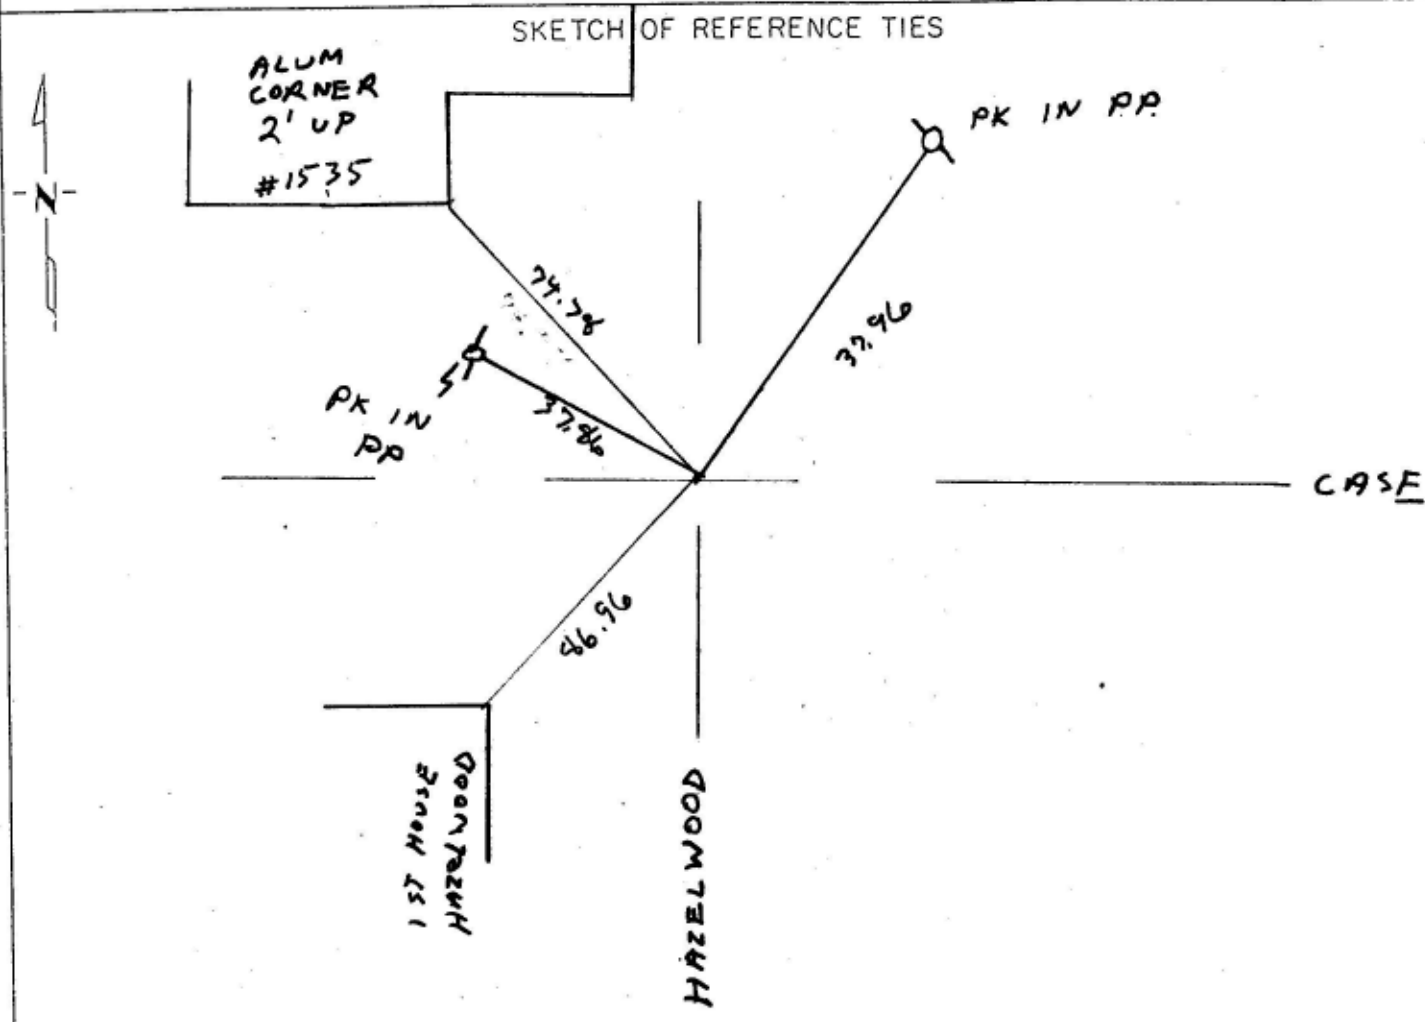

Statement of evidence relative to this corner location is on back of page.

I hereby certify that this document and the data contained herein was prepared by me or under my direct supervision



1 OCT 1992
DATE

Register of No. _____

Land Surveyor Professional Engineer

County Surveyor, County Engineer

OFFICE OF THE COUNTY RECORDER
County of _____

I hereby certify that this document was filed in the Co. Recorders office at _____ M. on the _____ day of _____ A.D., 19 _____

County Recorder _____

By _____, Deputy

DOCUMENT NO. _____

Scanned 5/11/99