

CERTIFICATE OF LOCATION OF GOVERNMENT CORNER


EAST QUARTER Corner of Section 27, Township 29, Range 22, 4th P.M.

STATE OF MINNESOTA, County of RAMSEY

At the corner location shown on the sketch:

- On 6/13/02 found a GRANITE MONUMENT IN CONC. BASE
DATE 0.2' BELOW GRADE KWM
 left monument as found, lowered monument, removed monument (explain)
- On 6/14/02 placed a MAGNET IN MONT. D.H. & PLACED
DATE SMALL BRASS CAP OVER MONUMENT @ GRADE.

SKETCH OF REFERENCE TIES

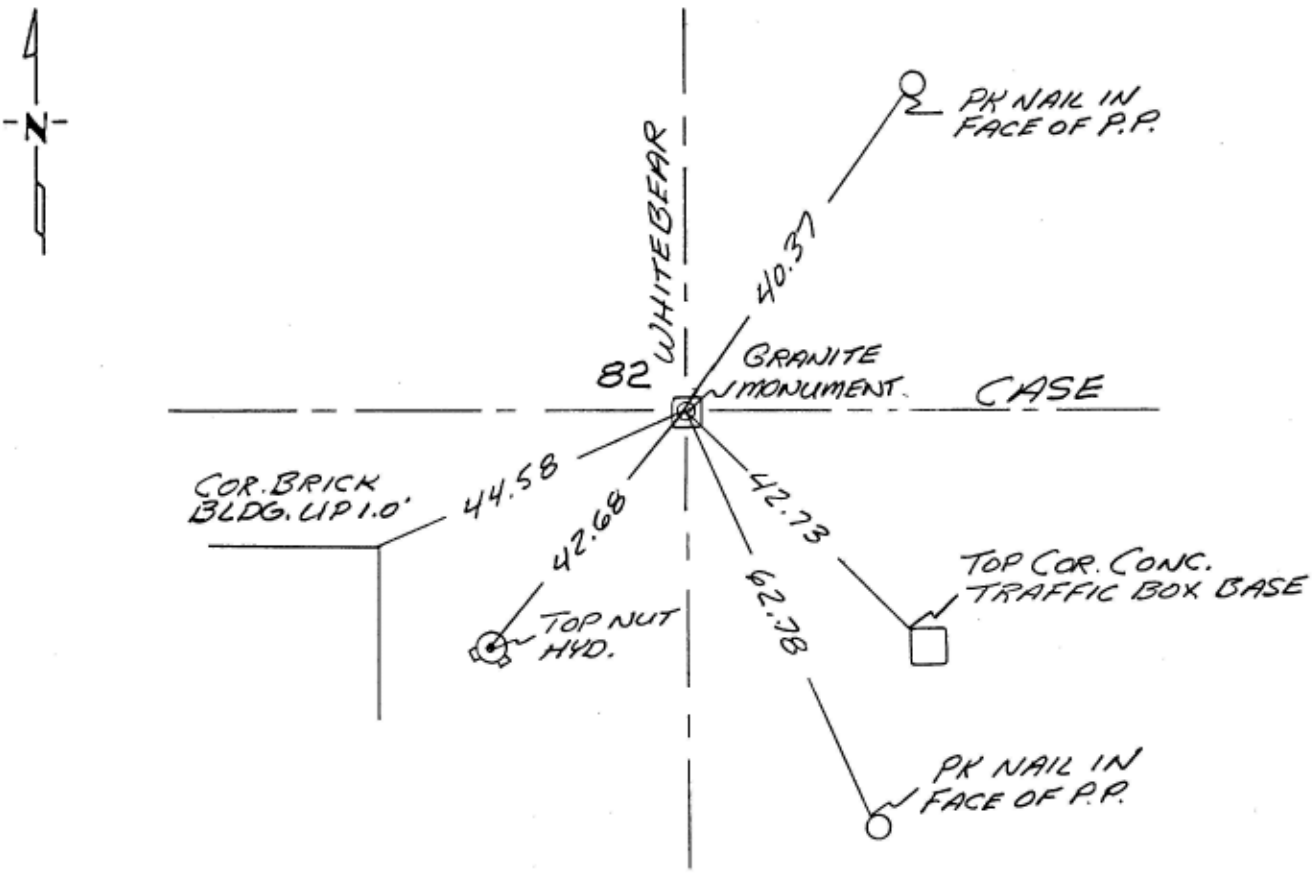

Statement of evidence relative to this corner location is on back of page.

I hereby certify that this document and the data contained herein was prepared by me or under my direct supervision.

[Signature] SIGNATURE 6/29/02 DATE
 Registration No. 13144
 Land Surveyor, Professional Engineer
 City Surveyor, County Engineer

OFFICE OF THE COUNTY RECORDER
County of _____

I hereby certify that this document was filed in the Co. Recorders office at _____ .M. on the _____ day of _____ A.D., 19 _____

County Recorder _____
By _____, Deputy
DOCUMENT NO. _____

Scanned 6/24/02