

# CERTIFICATE OF MONUMENT LOCATION

CITY MON. NO. 0088

OLD INDEX NO. 1005


1/4 Corner in the SE Qtr. of Section 28 Township 29 Range 23

STATE OF MINNESOTA, County of Ramsey  
At the corner location shown on the sketch:

On NOV 3, 2010 found a IRON PIN @ ASPHALT GRADE  
date

- left monument as found       lowered monument       removed monument (explain)

On NOV. 4, 2010 placed PHOTOS - TIES  
date

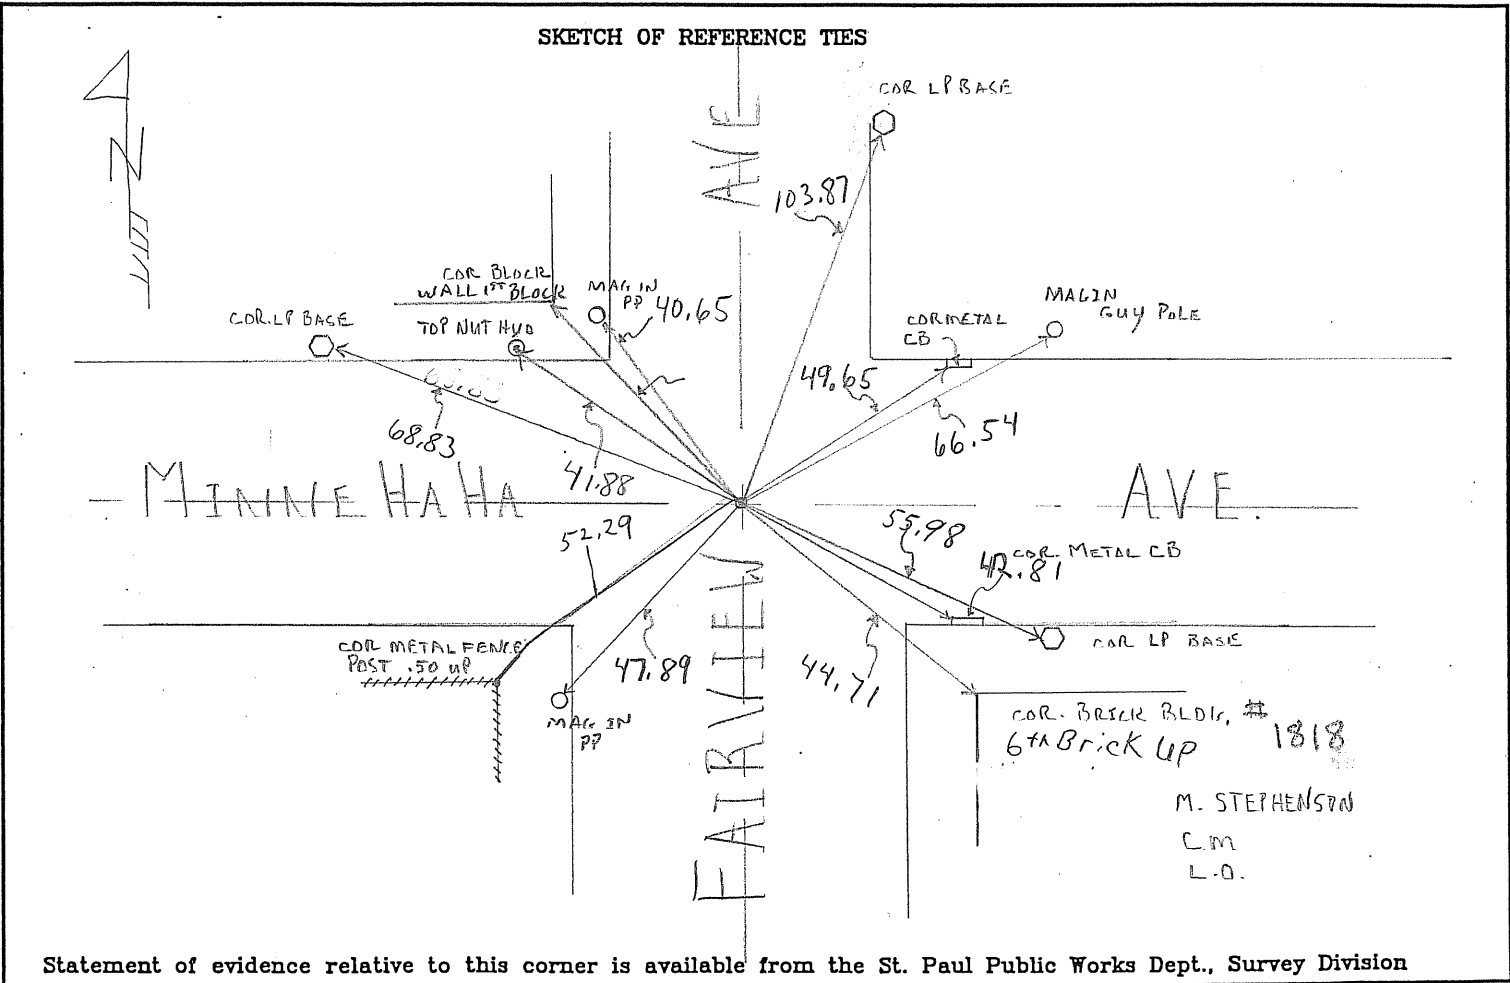

Statement of evidence relative to this corner is available from the St. Paul Public Works Dept., Survey Division

I hereby certify that this document and the data contained herein was prepared by me or under my direct supervision.

[Signature]      July 29, 2011  
SIGNATURE      DATE

Registration No. 44880

Land Surveyor       County Surveyor  
 Professional Engineer  
 Chief Surveyor, City of St. Paul

Office of The County Recorder, County of Ramsey

I hereby certify that this document was filed in the county Recorders office at \_\_\_\_\_ M. on the \_\_\_\_\_ day of \_\_\_\_\_

County Recorder \_\_\_\_\_  
By \_\_\_\_\_, Deputy

DOCUMENT NUMBER \_\_\_\_\_