

CERTIFICATE OF LOCATION OF GOVERNMENT CORNER

MON. NO. 92
OLD INDEX No 55

S 1/4 Corner of Section 26 Township 29 Range 23 4th P.M.


STATE OF MINNESOTA, County of Ramsey
At the corner location shown on the sketch:

On MAY 24 1999 found a CIM AT GRADE, PLACED TRANSIT TIES

left monument as found lowered monument removed monument (explain)

On _____ placed a _____

SKETCH OF REFERENCE TIES

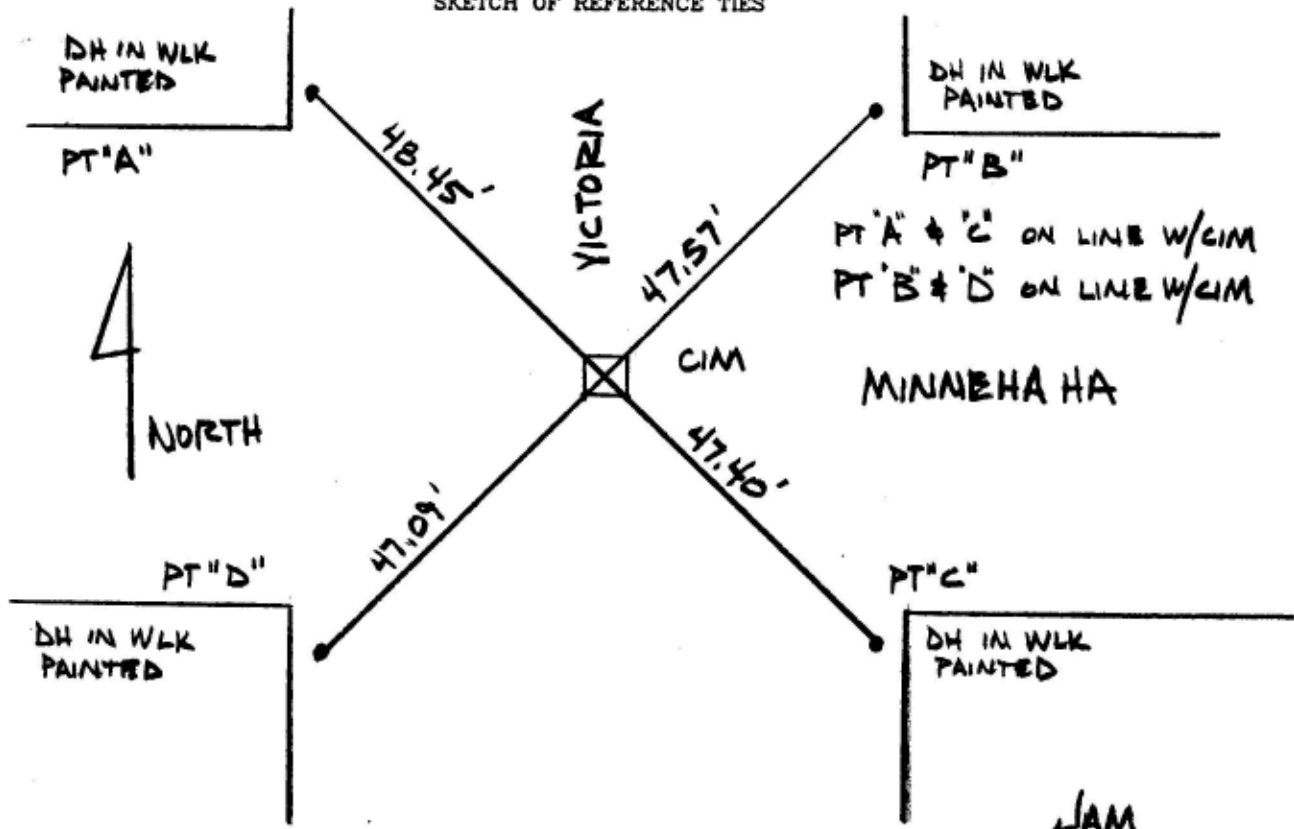

Statement of evidence relative to this corner is available from St. Paul Public Works Dept., Survey Division

I hereby certify that this document and the data contained herein was prepared by me or under my direct supervision.

[Signature] 5/27/99
SIGNATURE DATE

Registration No. 13144
 Land Surveyor County Surveyor
 Professional Engineer
 Chief Surveyor, City of St. Paul

Office of The County Recorder, County of Ramsey

I hereby certify that this document was filed in the county

Recorders office at _____ m. on the _____ day of _____

County Recorder _____

By _____, Deputy

DOCUMENT NUMBER _____