

CERTIFICATE OF LOCATION OF GOVERNMENT CORNER

City ID: 0092
Old Index #: 0055

N1/4 Corner of Section 35 Township 29 Range 23, 4th P.M.
STATE OF MINNESOTA, County of Ramsey
At the corner location shown on the sketch:


On Aug 21, 2015 found a CIM at street grade.

Photos taken and coordinates established using RTK-VRS GPS.

left monument as found lowered monument removed monument (explain)

On _____ placed a _____

SKETCH OF REFERENCE TIES

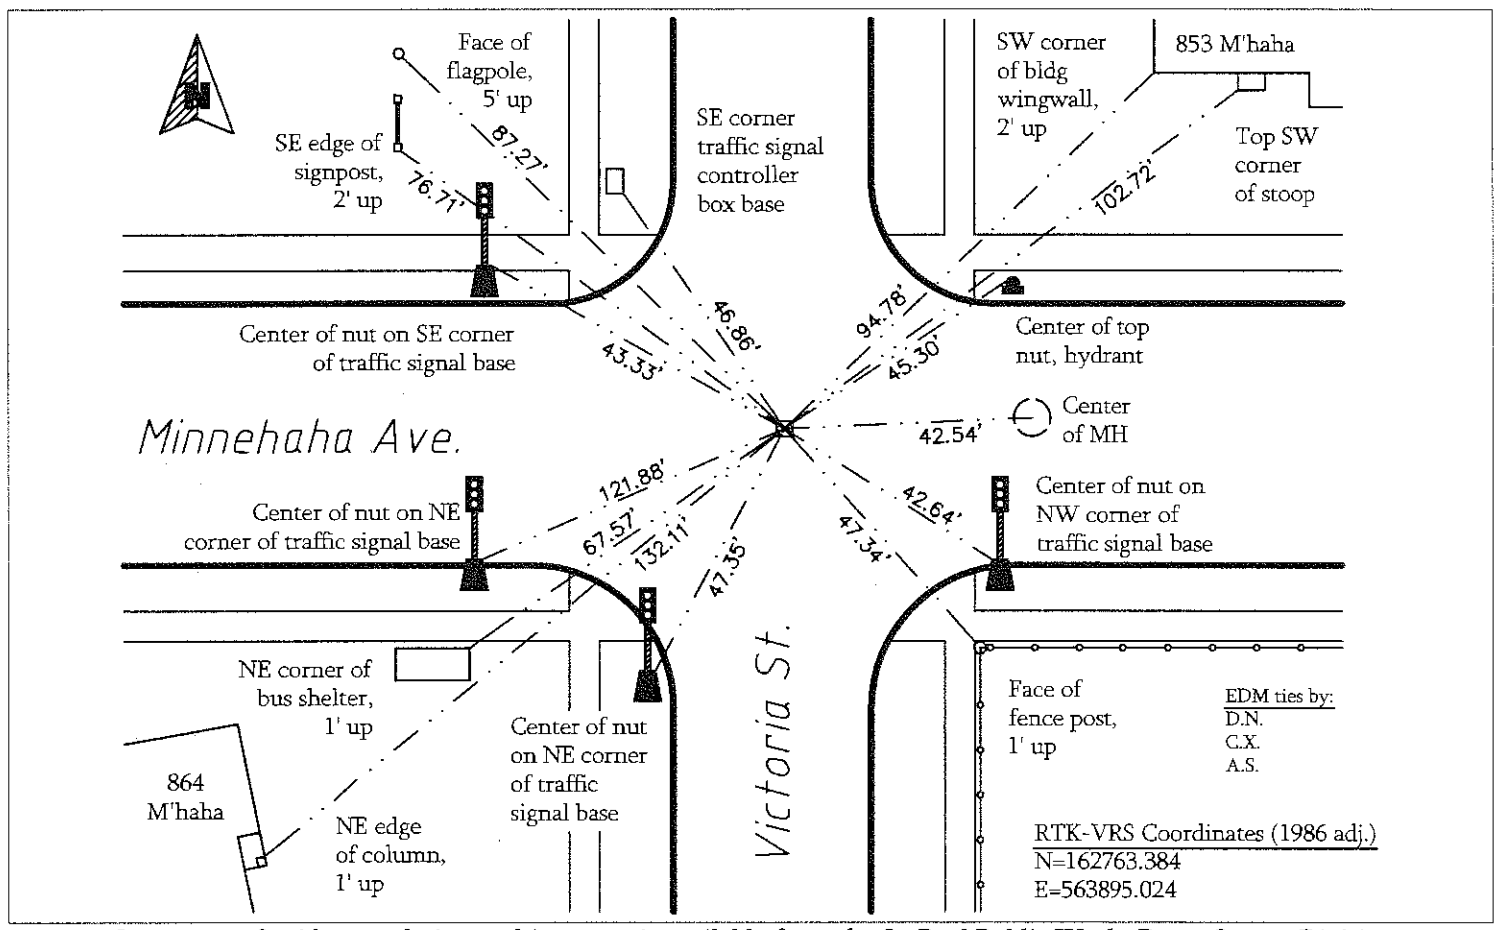

Statement of evidence relative to this corner is available from the St. Paul Public Works Dept., Survey Division

I hereby certify that this document and the data contained herein was prepared by me or under my direct supervision.

[Signature]
OCT 6, 2015
Registration No. 44880

- Land Surveyor County Surveyor
- Professional Engineer
- Chief Surveyor, City of St. Paul

Office of the County Recorder, County of Ramsey
I hereby certify that this document was filed in the county recorders office at _____ M. on the _____ day of _____

County Recorder _____

By _____, Deputy

DOCUMENT NUMBER _____