

CERTIFICATE OF LOCATION OF GOVERNMENT CORNER

City ID: 0098

Old Index #: 0067


1/4 Corner of Section 29&32 Township 29 Range 22, 4th P.M.
STATE OF MINNESOTA, County of Ramsey
At the corner location shown on the sketch:

On October 4, 2011 found a CIM with no cap 0.10' below milled surface.

left monument as found lowered monument removed monument (explain)
Damaged CIM replaced following mill & overlay

On October 10, 2011 placed a CIM to street grade. Ties meas'd electronically.

SKETCH OF REFERENCE TIES

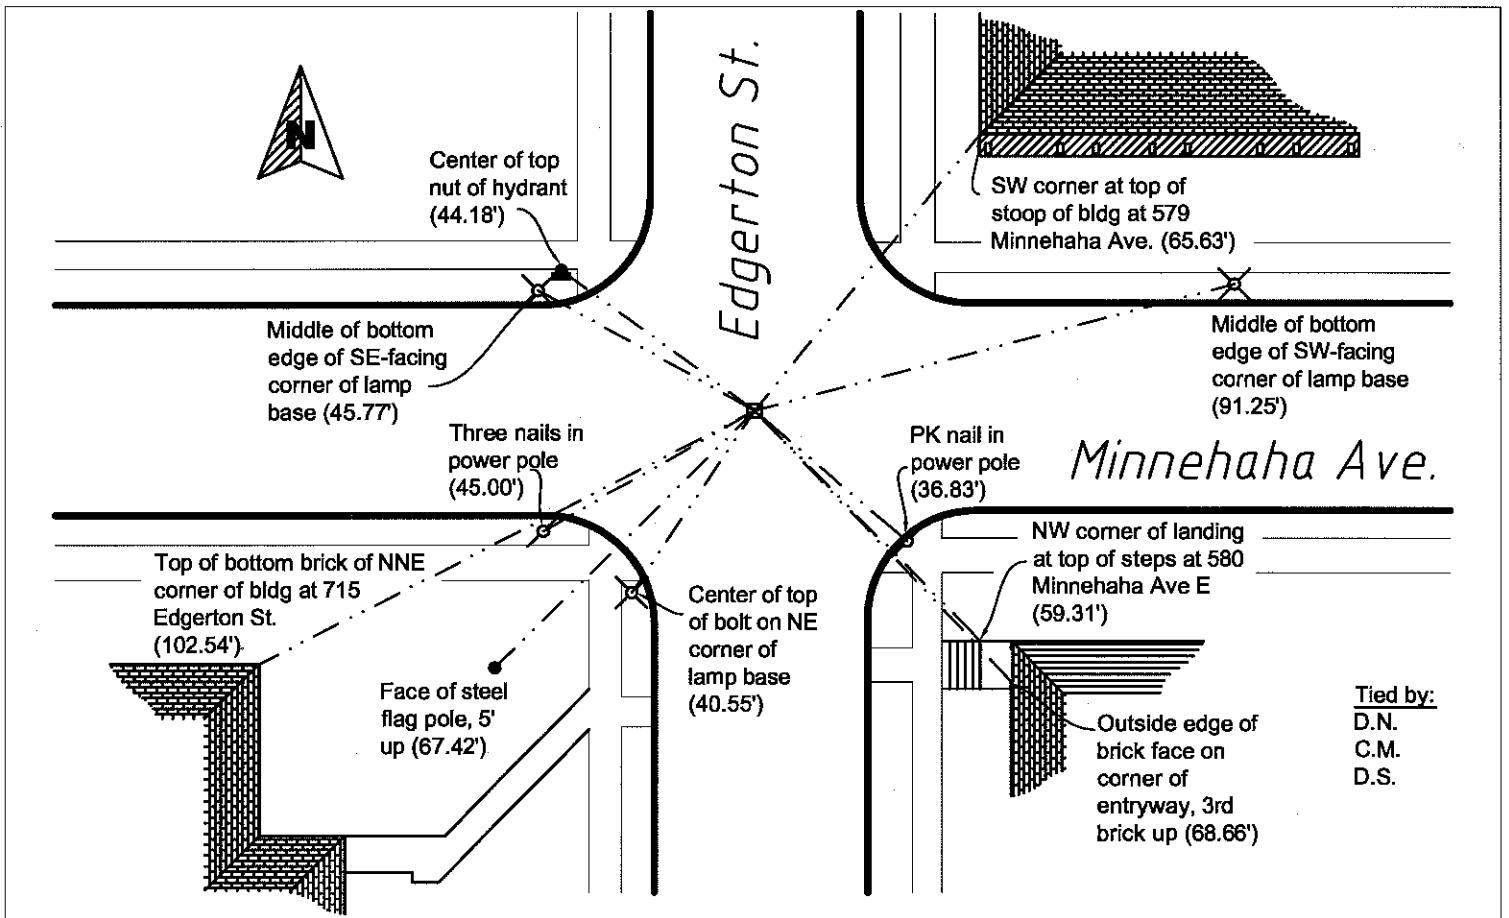

Tied by:
D.N.
C.M.
D.S.

Statement of evidence relative to this corner is available from the St. Paul Public Works Dept., Survey Division

I hereby certify that this document and the data contained herein was prepared by me or under my direct supervision.

Aug 17, 2012
Registration No. 44880

- Land Surveyor County Surveyor
 Professional Engineer
 Chief Surveyor, City of St. Paul

Office of the County Recorder, County of Ramsey
I hereby certify that this document was filed in the county recorders office at _____ M. on the _____ day of _____

County Recorder _____

By _____, Deputy

DOCUMENT NUMBER _____

SCANNED ON 9/9/12 by DAJ