

CERTIFICATE OF LOCATION OF GOVERNMENT CORNER

CITY MON. NO. 99

OLD INDEX NO. 69

SECTION common to Corner of Sections 28, 29, 32 Township 29 Range 22, 4 P.M.
33

STATE OF MINNESOTA, County of Ramsey


At the corner location shown on the sketch:

On Sept 18, 2002 found a 2 broken cim's, 1 cim bottom base

0.6 below grade, the other cim bottom base 2.1 below grade. *

- left monument as found
- lowered monument
- removed monuments (explain)

On Sept 19, 2002 placed a cim 0.04 below grade, monument
marked "SECTION CORNER"

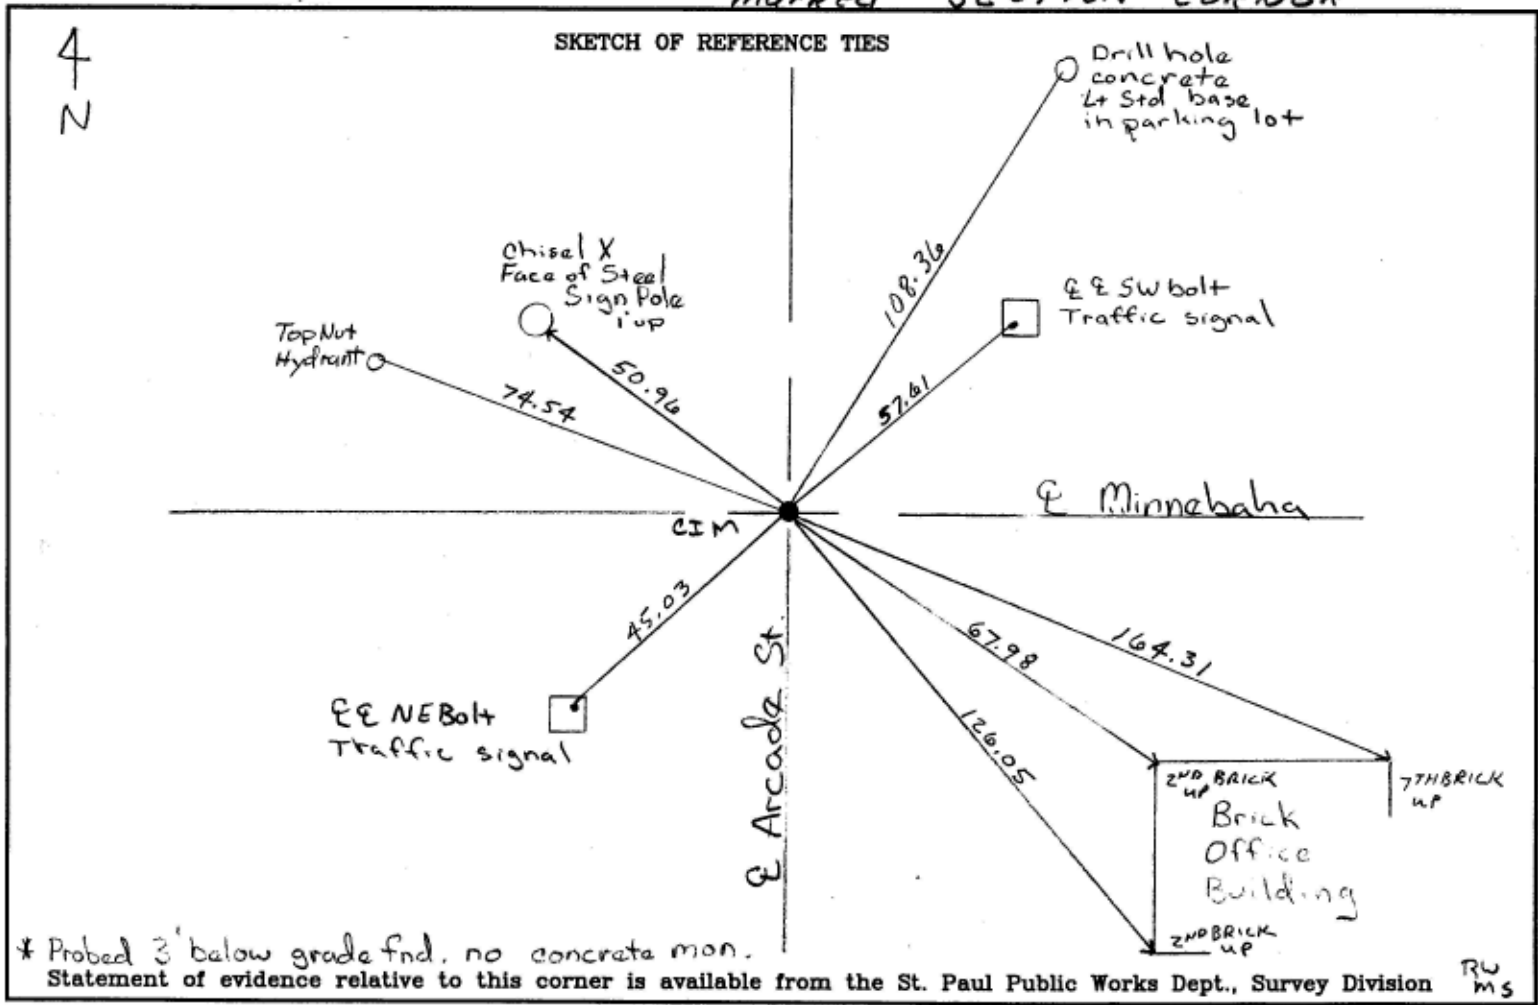

I hereby certify that this document and the data contained herein was prepared by me or under my direct supervision.

[Signature] 9/23
SIGNATURE DATE

Registration No. 13144

Land Surveyor County Surveyor

Professional Engineer

Chief Surveyor, City of St. Paul

Office of The County Recorder, County of Ramsey

I hereby certify that this document was filed in the county
Recorders office at _____ M. on the _____ day of _____

County Recorder _____

By _____, Deputy

DOCUMENT NUMBER _____