

0111-0985-A

CERTIFICATE OF LOCATION OF GOVERNMENT CORNER

CITY MON. NO. 111

OLD INDEX NO. 985

CENTER Corner of Section 34 Township 29 Range 23, 4TH P.M.


STATE OF MINNESOTA, County of Ramsey

At the corner location shown on the sketch:

On _____ found a _____
date

- left monument as found
 lowered monument
 removed monument (explain)

On April 5, 2006 placed a 4-2ft straddles / monument falls on SMH
date

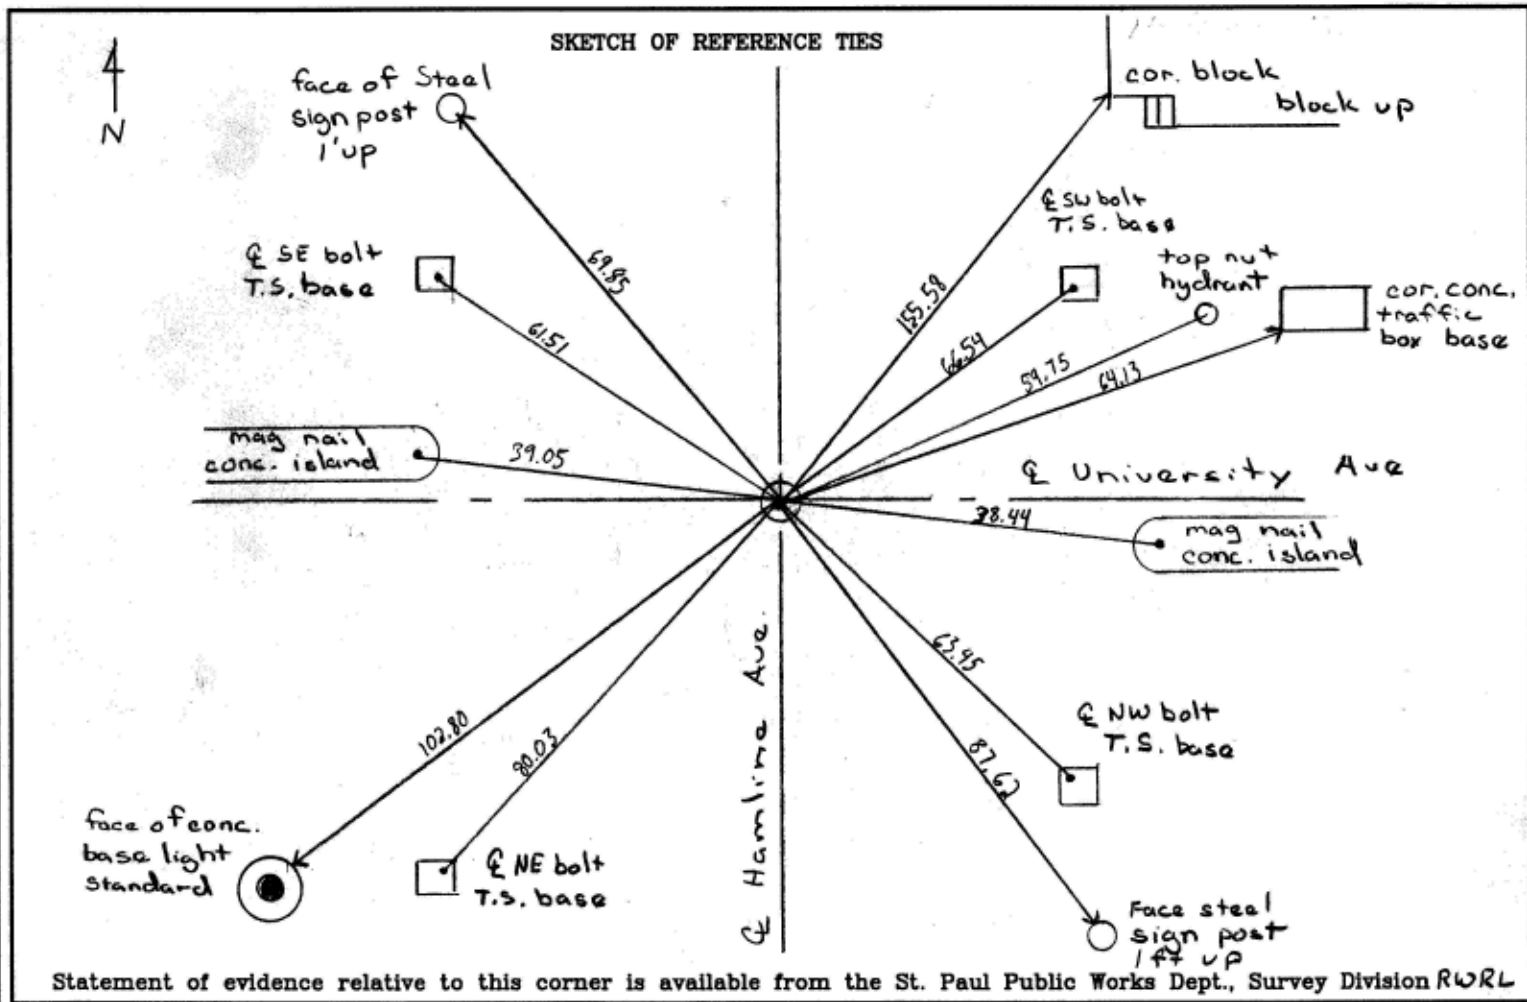

I hereby certify that this document and the data contained herein was prepared by me or under my direct supervision.

Michael P. Murphy 4/12/2006
SIGNATURE DATE

Registration No. 41,001

- Land Surveyor County Surveyor
 Professional Engineer
 Chief Surveyor, City of St. Paul

Office of The County Recorder, County of Ramsey

I hereby certify that this document was filed in the county
Recorders office at _____ M. on the _____ day of _____

County Recorder _____

By _____, Deputy

DOCUMENT NUMBER _____