

CERTIFICATE OF LOCATION OF GOVERNMENT CORNER

CITY MON. NO. 113

OLD INDEX NO. 77

CENTER Corner of Section 35 Township 29 Range 23, 4TH P.M.


STATE OF MINNESOTA, County of Ramsey

At the corner location shown on the sketch:

On April 4, 2006 found a PK nail at grade

- left monument as found
- lowered monument
- removed monument (explain)

On April 4, 2006 placed a CIM 0.02 below asphalt surface

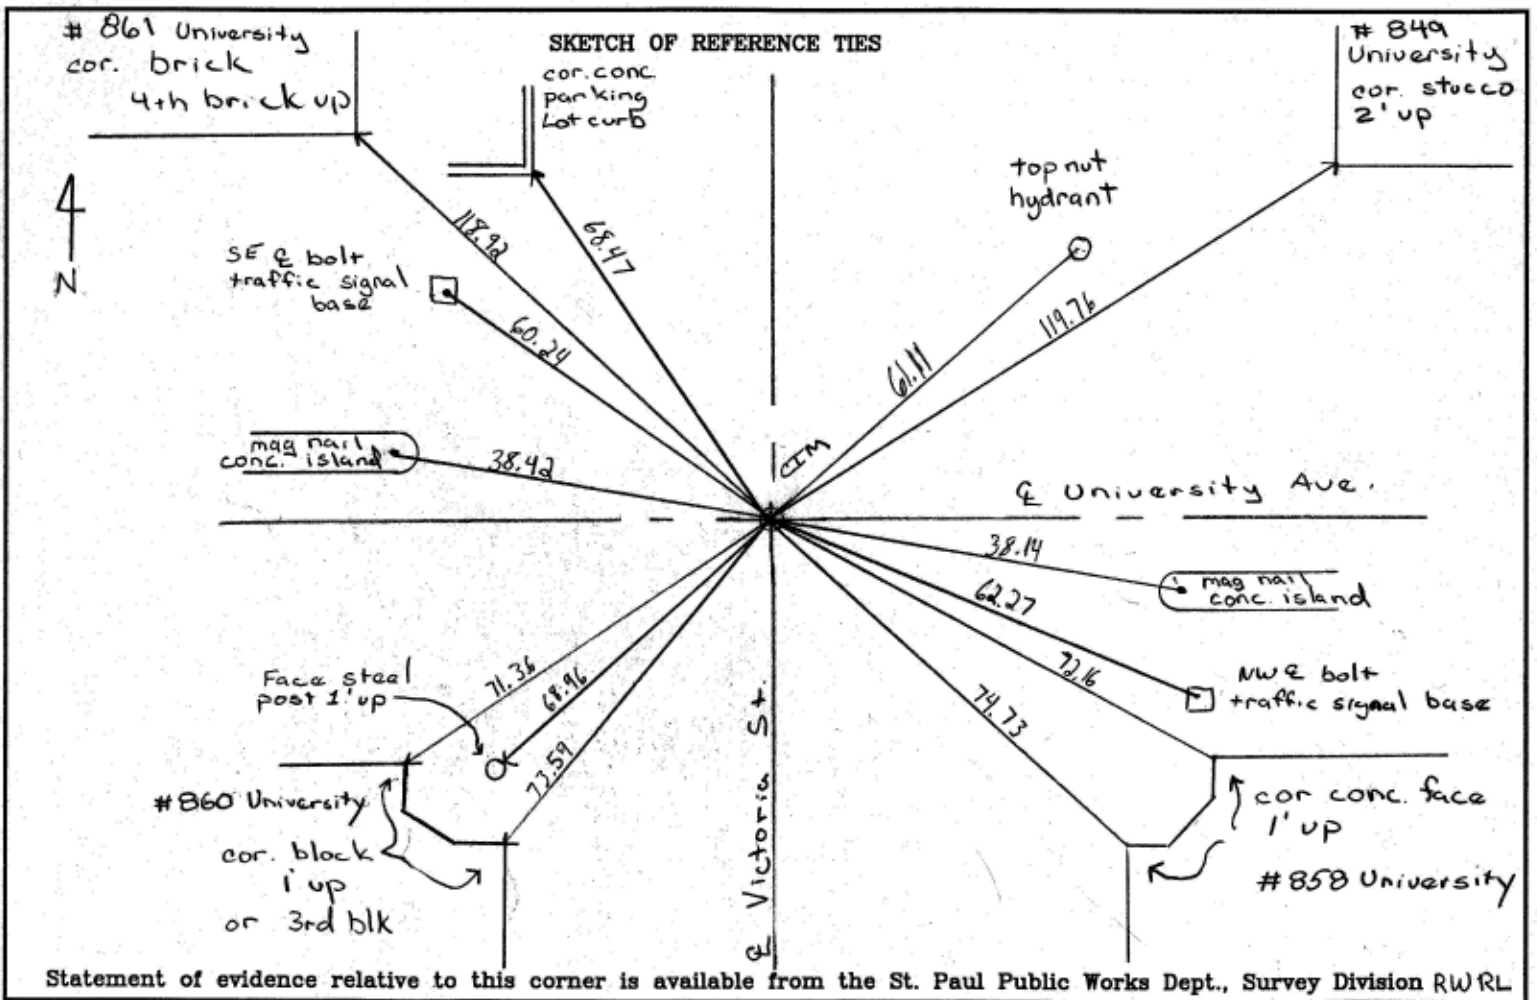

I hereby certify that this document and the data contained herein was prepared by me or under my direct supervision.

Michael P. Murphy 4/11/2006
SIGNATURE DATE

- Registration No. 41,001
- Land Surveyor
 - County Surveyor
 - Professional Engineer
 - Chief Surveyor, City of St. Paul

Office of The County Recorder, County of Ramsey

I hereby certify that this document was filed in the county Recorders office at _____ M. on the _____ day of _____

County Recorder _____

By _____, Deputy

DOCUMENT NUMBER _____