

CERTIFICATE OF LOCATION OF GOVERNMENT CORNER

CITY MON. NO. 114

OLD INDEX NO. 79

EAST 1/4 Corner of Section 35 Township 29 Range 23, 4TH P.M.


STATE OF MINNESOTA, County of Ramsey

At the corner location shown on the sketch:

On March 9, 2006 found 3 - 2ft straddles by SMH
date

- left monument as found
- lowered monument
- removed monument (explain)

On March 15, 2006 placed 1 - 2ft straddle
date

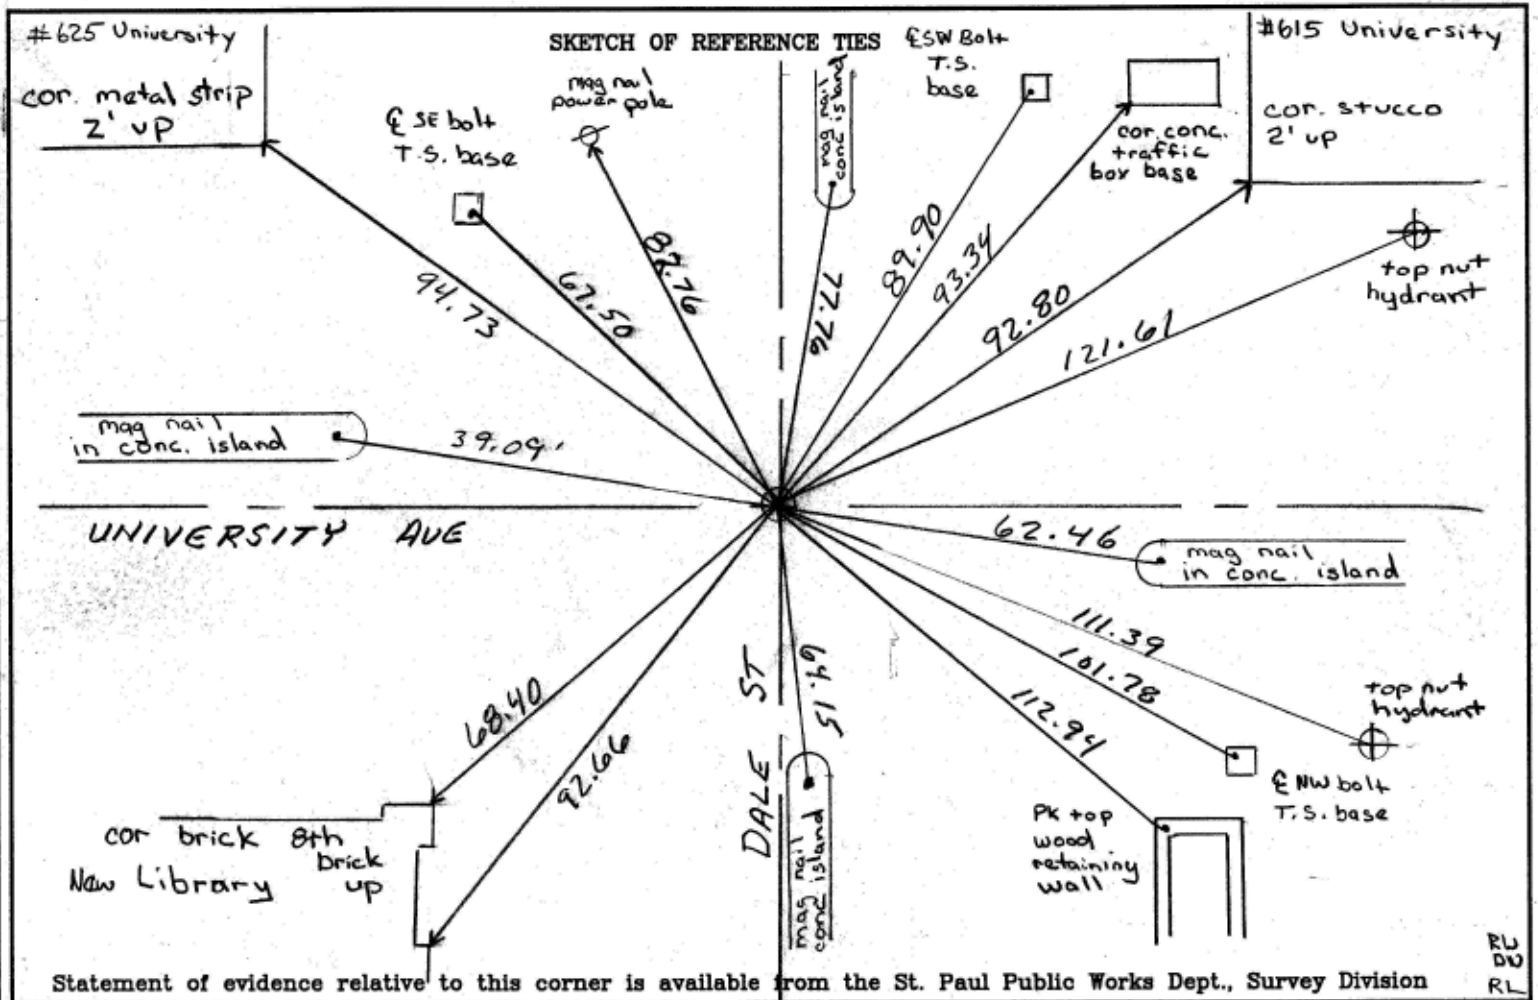

Statement of evidence relative to this corner is available from the St. Paul Public Works Dept., Survey Division

I hereby certify that this document and the data contained herein was prepared by me or under my direct supervision.

Michael P. Murphy 3/17/2006
SIGNATURE DATE

Registration No. 41,001

- Land Surveyor
- County Surveyor
- Professional Engineer
- Chief Surveyor, City of St. Paul

Office of The County Recorder, County of Ramsey

I hereby certify that this document was filed in the county
Recorders office at _____ M. on the _____ day of _____

County Recorder _____
By _____, Deputy

DOCUMENT NUMBER _____