

CERTIFICATE OF LOCATION OF GOVERNMENT CORNER

CITY MON. NO. 115

OLD INDEX NO. 81

Corner of Section _____ Township _____ Range _____ P.M.


STATE OF MINNESOTA, County of Ramsey

At the corner location shown on the sketch:

On 3-08-06 found a 4 - 2ft straddles by SMH

left monument as found lowered monument removed monument (explain)

On _____ placed a _____

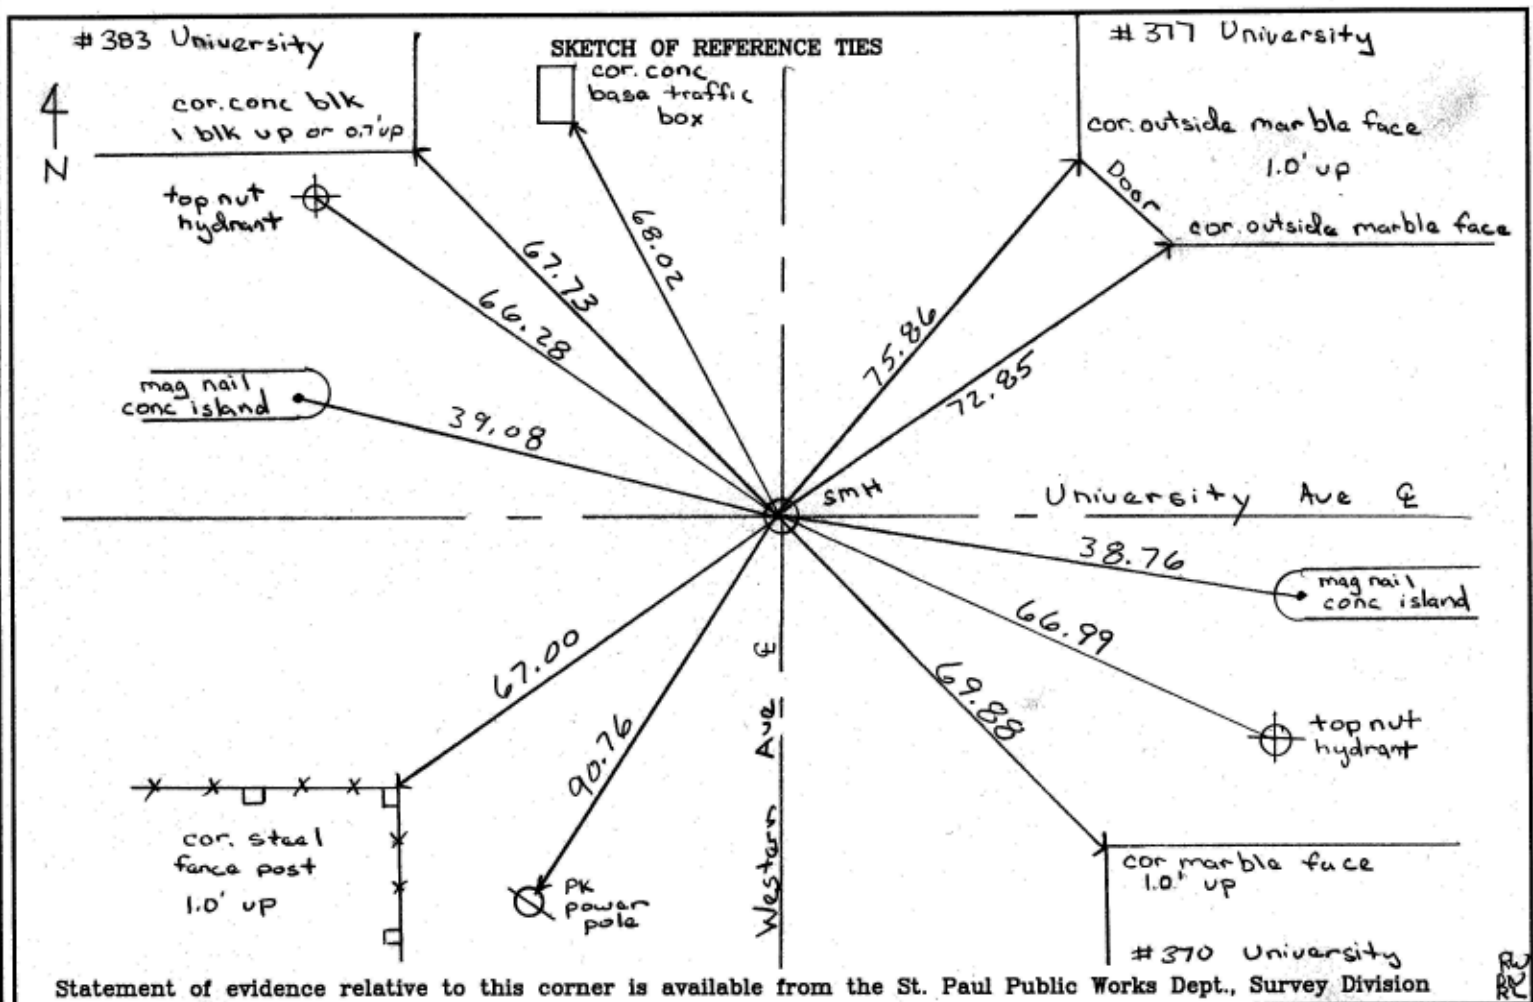

I hereby certify that this document and the data contained herein was prepared by me or under my direct supervision.

Michael P. Murphy 3/17/2006
SIGNATURE DATE

Registration No. 41,001
 Land Surveyor County Surveyor
 Professional Engineer
 Chief Surveyor, City of St. Paul

Office of The County Recorder, County of Ramsey

I hereby certify that this document was filed in the county Recorders office at _____ M. on the _____ day of _____

County Recorder _____

By _____, Deputy

DOCUMENT NUMBER _____