

CERTIFICATE OF LOCATION OF GOVERNMENT CORNER


West 1/4 Corner of Section 33, Township 29, Range 22, _____ P.M.

STATE OF MINNESOTA, County of RAMESEY

At the corner location shown on the sketch:

- On 13 OCT 92 found a BROKEN CI MONT
DATE CHECKED TIE
- left monument as found, lowered monument, removed monument (explain)
- On 13 OCT 92 placed a CAST IRON MONUMENT TO GRADE
DATE

SKETCH OF REFERENCE TIES

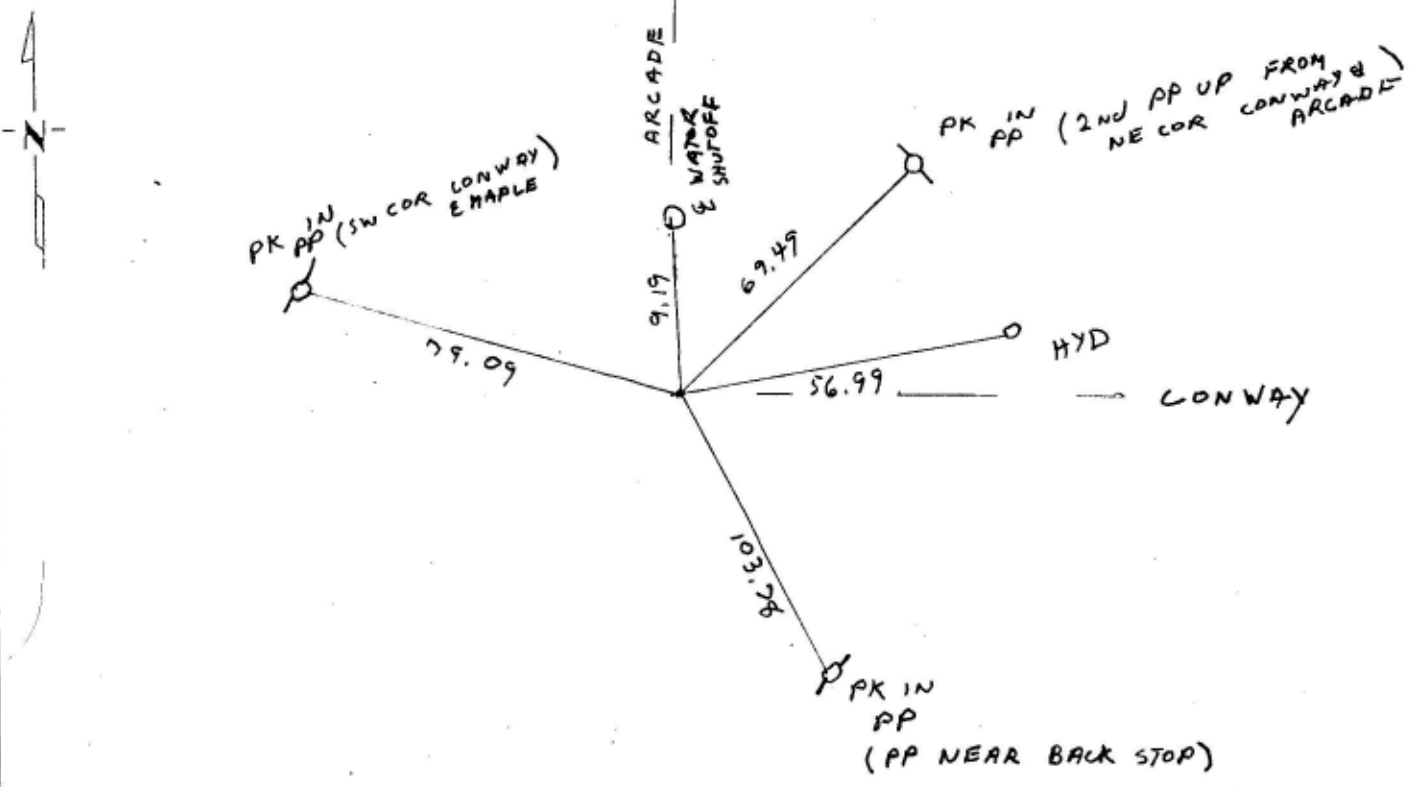

Statement of evidence relative to this corner location is on back of page.

I hereby certify that this document and the data contained herein was prepared by me or under my direct supervision.



OCT 16 1992
DATE

Registration No. _____

Land Surveyor, Professional Engineer

County Surveyor, County Engineer

OFFICE OF THE COUNTY RECORDER
County of _____

I hereby certify that this document was filed in the Co. Recorders office at _____ .M. on the _____ day of _____ A.D., 19 _____

County Recorder _____
By _____, Deputy
DOCUMENT NO. _____

Scanned 5/13/99